

SURVEY & REMONUMENTATION

AUG 31 1994

COMMISSION

BARRY COUNTY REMONUMENTATION

LAND CORNER RECORDATION CERTIFICATE
Filing Requirement of Act 74, Mich. P.A. 1970

STATE OF MICHIGAN
COUNTY OF BARRY
RECEIVED FOR RECORD

JUL 8 12 42 PM '94

Sandy Schendelmayer
REGISTER OF DEEDS

002206

Register of Deeds Stamp & File Number

For corners in BARRY
(County)

Located In: Corner Code #

- 1. Public Land Survey T 4N_R 9W I-11
T IRVING TWNSP.
T COR. SEC. 26, 27, 34 & 35
T R
- 2. Property Controlling in Section S T R
S T R
- 3. Miscellaneous Property in Sec. S T R
S T R
- 4. Lot No. _____, Recorded Plat _____
- 5. Private Claims _____

BRIAN REYNOLDS

28 APR

94

I, _____, in a field survey on _____, 19____, do hereby certify that under requirements of P.A. 74, Michigan P.A. of 1970, the corner points mentioned in lines 1 and 2 above were in conformance with regulations and rules therefore as required in the current manual of survey instructions of the United States Department of the Interior, Bureau of Land Management or by a decree of a Court of Law and/or that the corner points mentioned in lines 3, 4 and 5 above were in conformance with the rules of the Michigan Board of Land Surveyors or by a Decree of a Court of Law; established, re-established, monumented, re-monumented, recovered, found as expressed below:

NOTE: Not more than 4 corners, all in the same town and range, may be recorded on this certificate.


	A	B	C	D	E	F	G	H	I	J	K	L	M
2	6		5		4		3		2		1		
3													
4	7		8		9		10		11		12		
5													
6	18		17		16		15		14		13		
7													
8	19		20		21		22		23		24		
9													
10	30		29		28		27		26		25		
11													
12	31		32		33		34		35		36		
13													

- A. Description of original monument and accessories and/or subsequent restoration:
 - G.L.O.: SYLVESTER SIBLEY D.S., 1830 (R9W, Pg. 163-164):
W. OAK - 8 - S38W - 8; Do. -7 - N38E - 14
 - LEE COBB, 18 & 19 MAR 1892 (BOOK IX, Pg. 127):
FOUND BOTH U.S. BEARINGS GREEN.
 - GREG JENSEN, 1992, SET 1/2" IRON FROM WORK IN SECTION 27 IRVING TWNSP.:
- 10" MAPLE - N10E - 39.9'
- 14" HICKORY - N70W - 10.44'
- 24" OAK - S5E - 31.58'

- B. Description of corner evidence found and/or method applied in restoring or reestablishing corner:
 - FOUND 1/2" CAPPED IRON AS PER JENSEN'S (1992) WITNESSES.
AT INTERSECTION OF N. - S. - E. - W. FENCES.
ACCEPTED FOUND IRON AS BEST EVIDENCE OF CORNER POSITION.

ACT 345 BARRY COUNTY REMONUMENTATION
APPROVED BY PEER REVIEW AT A MEETING HELD ON
MAY 3, 1994 BR
BRIAN REYNOLDS COUNTY SURVEYOR

- C. Description of monument for corner and accessories established to perpetuate locating the position of the corner:
 - SET BARRY Co. REMONUMENTATION MONUMENT IN PLACE OF FOUND 1/2" IRON:
- AT INTERSECTION OF N. - S. - E. - W. FENCES
- FOUND SPIKE - E. FACE - 24" OAK - S5E - 31.58'
- FOUND SPIKE - N. FACE - 16" HICKORY - N80W - 10.44'
- FOUND SPIKE - W. FACE - 12" MAPLE - N. - 39.99'
- N&T - S. FACE - 30" OAK - N85W - 31.45'
- N&T - SE. FACE - S. TRUNK - TWIN OAK - N45E - 29.16'
- N&T - W. FACE - 14" OAK - N20W - 27.69'

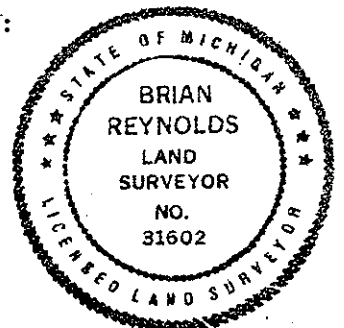

Signed by [Signature]

Date JUNE 20, 1994

Surveyor's Michigan License No. 31602