

SURVEY & REMONUMENTATION

AUG 22 1995

COMMISSION

BARRY COUNTY REMONUMENTATION

STATE OF MICHIGAN COUNTY OF BARRY RECEIVED FOR RECORD

JAN 25 8 34 AM '95

LAND CORNER RECORDATION CERTIFICATE Filing Requirement of Act 74, Mich. P.A. 1970

Sandy Schondelmarer REGISTER OF DEEDS

For corners in

BARRY (County)

Located In:

Corner Code #

- 1. Public Land Survey T 4N R 9W J-10
CENTER OF SECTION 26 IRVING TOWNSHIP
2. Property Controlling in Section S T R
3. Miscellaneous S T R Property in Sec. S T R

002262

Register of Deeds Stamp & File Number

- 4. Lot No. Recorded Plat
5. Private Claims

Grid table with columns A-M and rows 2-13. A black dot is located at the intersection of column I and row 10.

I, BRIAN REYNOLDS, in a field survey on 28 APRIL, 19 1994, do hereby certify that under requirements of P.A. 74, Michigan P.A. of 1970, the corner points mentioned in lines 1 and 2 above were in conformance with regulations and rules therefore as required in the current manual of survey instructions of the United States Department of the Interior, Bureau of Land Management or by a decree of a Court of Law and/or that the corner points mentioned in lines 3, 4 and 5 above were in conformance with the rules of the Michigan Board of Land Surveyors or by a Decree of a Court of Law; established, re-established, monumented, re-monumented, recovered, found as expressed below:

NOTE: Not more than 4 corners, all in the same town and range, may be recorded on this certificate.

A. Description of original monument and accessories and/or subsequent restoration:


- 1 CORNER NOT SET BY GENERAL LAND OFFICE
2 COUNTY SURVEYOR RECORDS: LEE COBB, 18 & 19 MARCH 1892 (LEE COBB, BOOK IX, PG.128) "SET STAKE"
3 NO OTHER RECORDED HISTORICAL INFORMATION AVAILABLE FOR THIS CORNER

B. Description of corner evidence found and/or method applied in restoring or reestablishing corner:

COMPUTED CENTER AT INTERSECTION OF 1/4 LINES. COMPUTED POSITION FELL ON A LARGE (6X8X24) STONE WITH POINTED TOP. ASSUMED STONE WAS USED TO REPRESENT CENTER OF SECTION. FELT COMPUTED POSITION WAS BEST FIT FOR HISTORICAL AND MATHEMATICAL POSITION.

REPLACED STONE WITH STANDARD BARRY COUNTY REMONUMENTATION MONUMENT

ACT 345 BARRY COUNTY REMONUMENTATION APPROVED BY PEER REVIEW AT A MEETING HELD ON MAY 3, 1994 BR BRIAN REYNOLDS COUNTY SURVEYOR

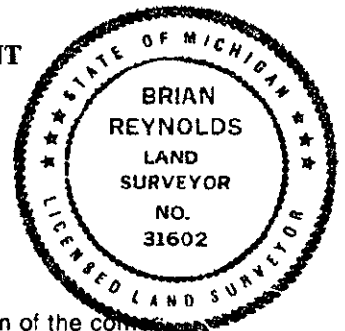

C. Description of monument for corner and accessories established to perpetuate locating the position of the corner:

SET STANDARD BARRY COUNTY REMONUMENTATION MONUMENT (3/4"X36"W/ALUMINUM CAP)
SET 40d NAIL W/REMON TAG IN SOUTH SIDE OF A 6" ELM S50°E 47.62'
SET 40d NAIL W/REMON TAG IN SOUTH SIDE OF AN 18" OAK N50°E 61.56'
SET 40d NAIL W/REMON TAG IN NORTH SIDE OF A 16" OAK N74°E 58.13'
SET 40d NAIL W/REMON TAG IN SOUTH SIDE OF UTILITY POLE #ME2,15,14 N53°W 41.08'
IN LINE WITH FENCE TO THE NORTH
ON WEST EDGE OF GRAVEL ROAD, JUST EAST OF WATERS EDGE
218'+/- SOUTH OF INTERSECTION OF RYAN & BUEHLER ROADS
SURROUNDED BY STONES

Signed by [Signature] Surveyor's Michigan License No. 31602

Date JAN 24, 1995