

SURVEY & REMONUMENTATION

AUG 31 1994

COMMISSION

**BARRY COUNTY REMONUMENTATION
LAND CORNER RECORDATION CERTIFICATE
Filing Requirement of Act 74, Mich. P.A. 1970**

STATE OF MICHIGAN
COUNTY OF BARRY
RECEIVED FOR RECORD

JUL 8 12 42 PM '94

Sandy Schondelmar
REGISTER OF DEEDS

For corners in **BARRY**
(County)

Located In: Corner Code =#

- 1. Public Land Survey T 4N R 9W J-11
T IRVING TOWNSHIP
T 1/4 COR. SEC. 26 & 35
T _____ R _____
- 2. Property Controlling S _____ T _____ R _____
in Section S _____ T _____ R _____
- 3. Miscellaneous S _____ T _____ R _____
Property in Sec. S _____ T _____ R _____
- 4. Lot No. _____, Recorded Plat _____
- 5. Private Claims _____

002204

Register of Deeds Stamp & File Number

BRIAN REYNOLDS

28 APR

94

I, _____, in a field survey on _____, 19_____, do hereby certify that under requirements of P.A. 74, Michigan P.A. of 1970, the corner points mentioned in lines 1 and 2 above were in conformance with regulations and rules therefore as required in the current manual of survey instructions of the United States Department of the Interior, Bureau of Land Management or by a decree of a Court of Law and/or that the corner points mentioned in lines 3, 4 and 5 above were in conformance with the rules of the Michigan Board of Land Surveyors or by a Decree of a Court of Law; established, re-established, monumented, re-monumented, recovered, found as expressed below:

NOTE: Not more than 4 corners, all in the same town and range, may be recorded on this certificate.

	A	B	C	D	E	F	G	H	I	J	K	L	M
2	6		5		4		3		2		1		
3													
4	7		8		9		10		11		12		
5													
6	16		17		18		19		20		21		22
7													
8	19		20		21		22		23		24		
9													
10	30		29		28		27		26		25		
11													
12	31		32		33		34		35		36		
13													

- A. Description of original monument and accessories and/or subsequent restoration:
 - G.L.O.: SYLVESTER SIBLEY D.S., 1830 (ROW, Pg. 164): WEST CORRECTED 40.07
W. OAK - 8 - N32W - 15; Do. -12 - S81E - 25
 - LEE COBB, 18 & 19 MAR 1892 (BOOK IX, Pg. 127):
FOUND STUMP OF ONE U.S. BEARING, W. OAK - 12 - S81E - 25.
SET STONE 18 x 9 x 8 & TILE (BROKEN).
 - L.C.R.C. # 394, DAVID F. PEABODY, DEC 1985, SET 3/8" IRON:
- IN CENTERLINE N. - S. ROAD; IN FENCE LINE E. - W.
- 16" HICKORY - S45W - 29.0'; 16" OAK - S30E - 47.0'
- FACE OF LARGE STONE - N75E - 21.0'

- B. Description of corner evidence found and/or method applied in restoring or reestablishing corner:

- FOUND 3/8" CAPPED IRON AS PER PEABODY'S (1985) WITNESSES.


FOUND IRON WAS IN A DEEP ROAD CUT. SECTION MEASUREMENTS WERE CONSISTENT WITH COBB'S SURVEY AND OTHER MONUMENTATION IN SECTION 26. ACCEPTED FOUND IRON AS BEST EVIDENCE OF CORNER POSITION.

ACT 345 BARRY COUNTY REMONUMENTATION
APPROVED BY PEER REVIEW AT A MEETING HELD ON

MAY 3, 1994 BR
BRIAN REYNOLDS COUNTY SURVEYOR

- C. Description of monument for corner and accessories established to perpetuate locating the position of the corner:

- SET BARRY Co. REMONUMENTATION MONUMENT IN PLACE OF FOUND 3/8" IRON:
- ON FENCE LINE E. - W.
- N&T - SW. FACE - 16" OAK - S26E - 47.96'
- N&T - SE. FACE - 16" HICKORY - S45W - 29.72'
- N&T - NW. FACE - S. TRUNK - 12" TWIN MAPLE - N10E - 130.40'
- N&T - NE. FACE - 6" MAPLE - N12W - 83.88'

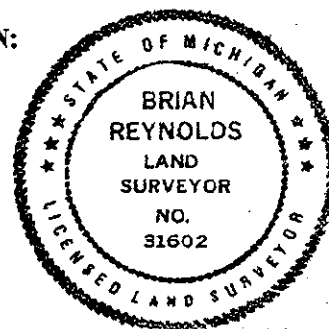

Signed by *[Signature]*

Date JUNE 20, 1994

Surveyor's Michigan License No. 31602