

BARRY COUNTY REMONUMENTATION

AUG 13 1998

LAND CORNER RECORDATION CERTIFICATE
Filing Requirement of Act 74, Mich. P.A. 1970

SECTION

For Corners in BARRY (county)

Located In:

Corner Code #



2683

Page: 1 of 1
04/23/1998 08:10A

1. Public Land Survey T 4N R 9W K-12
1/4 CORNER COMMON TO T R
SECTIONS 35 & 36 T R
IRVING TOWNSHIP T R

2. Property Controlling S T R
in Section S T R

3. Miscellaneous S T R
Property in Sec. S T R

4. Lot No. Recorded Plat

5. Private Claims

Register of Deeds Stamp & File Number

I, Brian Reynolds, in a field survey on 2 SEPTEMBER, 1997 do hereby certify that under requirements of P.A. 74, Michigan P.A. of 1970, the corner points mentioned in lines 1 and 2 above were in conformance with regulations and rules therefore as required in the current manual of survey instructions of the United States Department of the Interior, Bureau of Land Management or by a decree of a Court of Law and/or that the corner points mentioned in lines 3, 4, and 5 above were in conformance with the rules of the Michigan Board of Land Surveyors or by a Decree of a Court of Law; established, re-established, monumented, re-monumented, recovered, found as expressed below.

Table with 12 columns (A-L) and 13 rows (1-13) for recording corner points. Cell 12,36 is marked with a dot.

NOTE: Not more than 2 corners, all in the same town and range, may be recorded on this certificate.

A. Description of original monument and accessories and/or subsequent restoration:

- 1. GENERAL LAND OFFICE: SYLVESTER SIBLEY, D.S., 1830 (R9W, P.158) A. W. OAK 11 N78E 16 Do. 12 S42W 11
2. LAND CORNER RECORDATION CERTIFICATE: #395, BY DAVID F. PEABODY, 21 DECEMBER, 1988, "LARGE STONE" IN FENCE LINE TO SOUTH 36" OAK S30°W 3.5' 24" OAK S05°W 62.0' 12" OAK WEST 66.1'

*** NO OTHER HISTORICAL INFORMATION, PUBLIC OR PRIVATE, AVAILABLE FOR THIS CORNER ***

B. Description of corner evidence found and/or method applied in restoring or reestablishing corner:

AT INTERSECTION OF FENCES, FOUND 20" X 15" X 12"+STONE PARTLY OVERGROWN BY A 48"+ OAK TREE, AND ONE WITNESS BY PEABODY (OAK WEST). ACCEPTED FOUND STONE AS CORNER POSITION.

WE WERE UNABLE TO REMOVE FOUND STONE. A 48"+ OAK TREE WHICH IS BEING USED AS A FENCE CORNER, HAS GROWN AROUND AND PARTIALLY OVER STONE. LEFT STONE IN PLACE. MARK IS A WELL DEFINED HIGH POINT ON THE NORTHWEST CORNER OF STONE. PLACED TWO RAILROAD SPIKES UNDER HOLLOW PORTION OF TREE ON WEST SIDE OF STONE TO PROVIDE MAGNETIC INDICATION.


C. Description of monument for corner and accessories established to perpetuate locating the position of the corner:

UNABLE TO REMOVE STONE. LEFT 20" X 15" X 12"+ STONE IN PLACE FOR CORNER. 48"+ OAK TREE HAS GROWN AROUND STONE, MARK IS A WELL DEFINED HIGH POINT ON THE NORTHWEST CORNER OF STONE, WITH TWO RAILROAD SPIKES UNDER HOLLOW PORTION OF TREE ON WEST SIDE OF STONE TO PROVIDE MAGNETIC INDICATION.

- FOUND 60d NAIL IN THE EAST SIDE OF A 16" OAK S02°E 32.35'
FOUND 60d NAIL IN THE NORTH SIDE OF A 10" SASSAFRASS N90°E 31.00'
FOUND 60d NAIL IN THE NORTH SIDE OF AN 18" OAK N89°W 66.00'
FOUND 60d NAIL IN THE EAST SIDE OF A 48" OAK (TREE GROWN AROUND STONE) S12°E (TO NAIL) 2.40'
0.5' NORTH OF FENCE WEST IN LINE WITH FENCE SOUTH

ACT 345 BARRY COUNTY REMONUMENTATION
APPROVED BY PEER REVIEW AT A MEETING HELD ON

8 Sept. 97 BR
BRIAN REYNOLDS COUNTY SURVEYOR

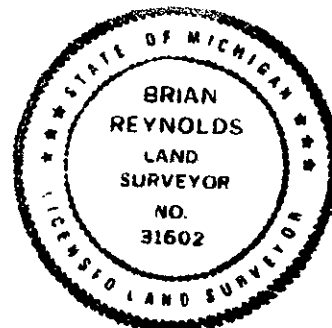

Signed by [Signature]
Surveyor's Michigan License No 31602

Date APRIL 20, 1998