

SURVEY & REMONUMENTATION

NOV 04 1995

COMMISSION

BARRY COUNTY REMONUMENTATION

STATE OF MICHIGAN
COUNTY OF BARRY
RECEIVED FOR RECORD

LAND CORNER RECORDATION CERTIFICATE AUG 20 11 27 AM '96
Filing Requirement of Act 74, Mich. P.A. 1970

For corners in

BARRY

(County)

Located In:

Corner Code **##**

Sandy Schondelmarper

REGISTER OF DEEDS

002388

Register of Deeds Stamp & File Number

- 1. Public Land Survey T 4N R 9W Corner Code K-13
SECTION CORNER COMMON TO T _____ R _____
SECTIONS 35 & 36 IRVING TOWNSHIP R _____
ON TOWNSHIP LINE T _____ R _____
- 2. Property Controlling S _____ T _____ R _____
in Section S _____ T _____ R _____
- 3. Miscellaneous S _____ T _____ R _____
Property in Sec. S _____ T _____ R _____
- 4. Lot No. _____, Recorded Plat _____
- 5. Private Claims _____

| | A | B | C | D | E | F | G | H | I | J | K | L | M |
|----|----|----|----|----|----|----|---|---|---|---|---|---|---|
| 2 | 6 | 5 | 4 | 3 | 2 | 1 | | | | | | | |
| 3 | | | | | | | | | | | | | |
| 4 | 7 | 8 | 9 | 10 | 11 | 12 | | | | | | | |
| 5 | | | | | | | | | | | | | |
| 6 | 18 | 17 | 16 | 15 | 14 | 13 | | | | | | | |
| 7 | | | | | | | | | | | | | |
| 8 | 19 | 20 | 21 | 22 | 23 | 24 | | | | | | | |
| 9 | | | | | | | | | | | | | |
| 10 | 30 | 29 | 28 | 27 | 26 | 25 | | | | | | | |
| 11 | | | | | | | | | | | | | |
| 12 | 31 | 32 | 33 | 34 | 35 | 36 | | | | | | | |
| 13 | | | | | | | | | | | | | |

I, **BRIAN REYNOLDS**, in a field survey on **31 MARCH**, 19**95**
do hereby certify that under requirements of P.A. 74, Michigan P.A. of 1970, the corner points mentioned in lines 1 and 2 above were in conformance with regulations and rules therefore as required in the current manual of survey instructions of the United States Department of the Interior, Bureau of Land Management or by a decree of a Court of Law and/or that the corner points mentioned in lines 3, 4 and 5 above were in conformance with the rules of the Michigan Board of Land Surveyors or by a Decree of a Court of Law, established, re-established, monumented, re-monumented, recovered, found as expressed below:

NOTE: Not more than 4 corners, all in the same town and range, may be recorded on this certificate.


A. Description of original monument and accessories and/or subsequent restoration:

**GENERAL LAND OFFICE: L. LYON, D.S., 1826(R9W, P.148)
W. OAK 20 N59E 12 Do. 20 N27W 67
LAND CORNER RECORDATION CERTIFICATE #395, BY DAVID F. PEABODY, P.S.#25866 "IRON"
SQ. SPIKE IN E'LY FACE 48" OAK S25°W, 41.5' S'LY FACE 44" OAK NORTH 27'
IN CENTERLINE E&W ROAD 24'+/- E. OF FENCE TO SOUTH
SQ. SPIKE IN S'LY FACE 30" OAK N70°E, 94.3' NE COR., SEC. 2, RUTLAND TWP., WEST 23.76'**

NO OTHER RECORDED HISTORICAL INFORMATION AVAILABLE FOR THIS CORNER

B. Description of corner evidence found and/or method applied in restoring or reestablishing corner:

**FOUND NO EVIDENCE OF CORNER MONUMENTATION. WITNESSES BY PEABODY (ABOVE) FOUND OVERGROWN REESTABLISHED CORNER FROM WITNESSES BY PEABODY. TRAVERSE 1 MILE EAST AND 2 MILES WEST CONFIRM POSITION BY PEABODY IS ON TOWN LINE AND AT THE GOVERNMENT JOG.
SET STANDARD BARRY COUNTY REMONUMENTATION MONUMENT ON TOWN LINE AND AT GOVERNMENT JOG.**

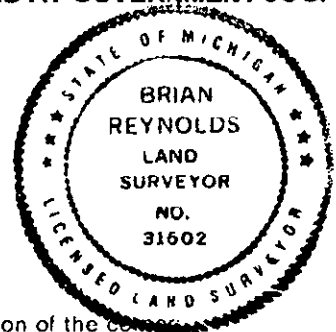

C. Description of monument for corner and accessories established to perpetuate locating the position of the corner:

**SET STANDARD BARRY COUNTY REMONUMENTATION MONUMENT (3/4"X36"W/ALUMINUM CAP)
SET 40d NAIL W/PLASTIC TAG IN THE EAST SIDE OF A 60" OAK N3°W 28.77'
SET 40d NAIL W/PLASTIC TAG IN THE EAST SIDE OF A 60" OAK S30°W 41.25'
SET 40d NAIL W/PLASTIC TAG IN THE SOUTH SIDE OF A 12" BLACK WALNUT N38°W 38.17'
SET 40d NAIL W/PLASTIC TAG IN THE NORTH SIDE OF A 36" OAK N70°E 94.33'
K-1 OF T3N, R9W, RUTLAND TOWNSHIP IS WEST 23.76'
IN LINE WITH FENCE/TREE LINE NORTH**

ACT 345 BARRY COUNTY REMONUMENTATION
APPROVED BY PEER REVIEW AT A MEETING HELD ON

APRIL 10 1995 BR
BRIAN REYNOLDS COUNTY SURVEYOR

Signed by *[Signature]*
Surveyor's Michigan License No. 31602

Date AUGUST 16, 1996