

SURVEY & REMONUMENTATION

BARRY COUNTY REMONUMENTATION

AUG 13 1998

LAND CORNER RECORDATION CERTIFICATE
Filing Requirement of Act 74, Mich. P.A. 1970

For Corners in **SECTION**
BARRY
(county)

Located In: Corner Code #



2680

Page: 1 of 1
04/23/1998 08:10A

- 1. Public Land Survey **T 4N R 9W** **L-12**
CENTER OF SECTION 36
IRVING TOWNSHIP
- 2. Property Controlling S ___ T ___ R ___
in Section S ___ T ___ R ___
- 3. Miscellaneous S ___ T ___ R ___
Property in Sec. S ___ T ___ R ___
- 4. Lot No: _____, Recorded Plat _____
- 5. Private Claims _____

Sandy Schondeimayer - Barry Co. LORCR

Register of Deeds Stamp & File Number

I, **Brian Reynolds**, in a field survey on **2 SEPTEMBER, 1997** do hereby certify that under requirements of P.A. 74, Michigan P.A. of 1970, the corner points mentioned in lines 1 and 2 above were in conformance with regulations and rules therefore as required in the current manual of survey instructions of the United States Department of the Interior, Bureau of Land Management or by a decree of a Court of Law and/or that the corner points mentioned in lines 3, 4, and 5 above were in conformance with the rules of the Michigan Board of Land Surveyors or by a Decree of a Court of Law; established, re-established, monumented, re-monumented, recovered, found as expressed below.

	A	B	C	D	E	F	G	H	I	J	K	L	M
2	6	5	4	3	2	1							
3													
4	7	8	9	10	11	12							
5													
6	18	17	16	15	14	13							
7													
8	19	20	21	22	23	24							
9													
10	30	29	28	27	26	25							
11													
12	31	32	33	34	35								
13													

NOTE: Not more than 2 corners, all in the same town and range, may be recorded on this certificate.

A. Description of original monument and accessories and/or subsequent restoration:

- 1. **THIS CORNER WAS NOT SET BY THE GENERAL LAND OFFICE.**
- 2. **COUNTY SURVEYOR RECORDS: FRANK S. BOWEN, 1875 (L.1, P.99) "SET @ INT. 1/4 LINES"**
B. OAK 10 N73W 11 1/2 W. OAK 18 N58E 112
- 3. **COUNTY SURVEYOR RECORDS: FRANK S. BOWEN, 1877 (L.1, P.195)**
B. OAK N61W 7 1/2 W. OAK 18 N60E 115

***** NO OTHER HISTORICAL INFORMATION, PUBLIC OR PRIVATE, AVAILABLE FOR THIS CORNER *****

B. Description of corner evidence found and/or method applied in restoring or reestablishing corner:


FOUND NO MAGNETIC EVIDENCE OF CORNER POSITION. COUNTY SURVEYOR FRANK BOWEN RECITES DISTANCES AND BEARINGS TO HIS WITNESS TREES THAT CONFLICT ONE WITH THE OTHER (ITEMS #1 & #2). TIED IN THE 4 CORRESPONDING 1/4 CORNERS & SET MONUMENT AT INTERSECTION OF 1/4 LINES, 21'+/- SOUTH OF AN ANGLE IRON FENCE CORNER POST. FOUND STUMP OF A LARGE OAK TREE WEST-NORTHWEST, POSSIBLY A WITNESS TREE FROM SURVEY BY BOWEN (B. OAK N61W 7 1/2lks, 4.95' & B. OAK N73W 11 1/2lks, 7.59') (MEASURED N80°W 6.5'+/- TO CENTER OF STUMP). ACCEPTED INTERSECTION OF 1/4 LINES AS BEST AVAILABLE EVIDENCE OF CORNER POSITION. SET STANDARD BARRY COUNTY REMONUMENTATION MONUMENT AT INTERSECTION OF 1/4 LINES.

C. Description of monument for corner and accessories established to perpetuate locating the position of the corner:

**SET STANDARD BARRY COUNTY REMONUMENTATION MONUMENT (3/4" X 36" IRON) WITH ALUMINUM CAP.
SET 20d NAIL W/PLASTIC TAG IN THE NORTH SIDE OF A 6" CHERRY S85°E 8.89'
SET 20d NAIL W/PLASTIC TAG IN THE SOUTH SIDE OF A 14" CHERRY N85°E 28.50'
SET 20d NAIL W/PLASTIC TAG IN THE NORTHEAST SIDE OF AN 8" CHERRY S30°E 35.80'
SET 20d NAIL W/PLASTIC TAG IN THE EAST SIDE OF A 12" OAK S09°W 20.69'
SET 20d NAIL W/PLASTIC TAG IN THE NORTH SIDE OF A 34" OAK N89°W 20.67'
SET 20d NAIL W/PLASTIC TAG IN THE SOUTHWEST SIDE OF A 14" OAK N32°W 12.96'
TOP CENTER OF A 3" ANGLE IRON CORNER POST N07W 20.87'
CORNER LIES 2.5' EAST OF A NORTH-SOUTH DECAYING FENCE LINE
21'+/- SOUTH OF AN EAST-WEST STANDING FENCE**

**ACT 345 BARRY COUNTY REMONUMENTATION
APPROVED BY PEER REVIEW AT A MEETING HELD ON**

8 Sept. '97 BR
BRIAN REYNOLDS COUNTY SURVEYOR

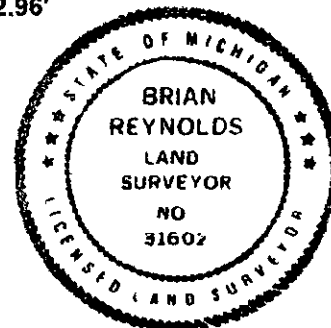

Signed by *Brian Reynolds*
Surveyor's Michigan License No 31602

Date APRIL 20, 1998