

NOV 04 1996

COMMISSION

BARRY COUNTY REMONUMENTATION

LAND CORNER RECORDATION CERTIFICATE
Filing Requirement of Act 74, Mich. P.A. 1970

STATE OF MICHIGAN
COUNTY OF BARRY
RECEIVED FOR RECORD

AUG 20 11 27 AM '96

Sandy Schindelmaier

REGISTER OF DEEDS

002387

Register of Deeds Stamp & File Number

For corners in

BARRY

(County)

Located In:

Corner Code #

- 1. Public Land Survey T 4N R9W L-13
- SOUTH 1/4 CORNER OF SECTION T _____ R _____
- 36 IRVING TOWNSHIP T _____ R _____
- ON TOWNSHIP LINE T _____ R _____
- 2. Property Controlling S _____ T _____ R _____
- in Section S _____ T _____ R _____
- 3. Miscellaneous S _____ T _____ R _____
- Property in Sec. S _____ T _____ R _____

- 4. Lot No. _____, Recorded Plat _____
- 5. Private Claims _____

BRIAN REYNOLDS in a field survey on 31 MARCH 1995

do hereby certify that under requirements of P.A. 74, Michigan P.A. of 1970, the corner points mentioned in lines 1 and 2 above were in conformance with regulations and rules therefore as required in the current manual of survey instructions of the United States Department of the Interior, Bureau of Land Management or by a decree of a Court of Law and/or that the corner points mentioned in lines 3, 4 and 5 above were in conformance with the rules of the Michigan Board of Land Surveyors or by a Decree of a Court of Law, established, re-established, monumented, re-monumented, recovered, found as expressed below:

NOTE: Not more than 4 corners, all in the same town and range, may be recorded on this certificate.

A. Description of original monument and accessories and/or subsequent restoration.

GENERAL LAND OFFICE: L. LYON, D.S., 1826(R9W, P.148)
W. OAK 11 N41E 15 B. OAK 6 N56W 57
COUNTY SURVEYOR RECORDS: BOWEN, 1877(L.1,P.195)
W. OAK 5 N57 1/2W 57 B. OAK 6 N47E 48


NO OTHER RECORDED HISTORICAL INFORMATION AVAILABLE FOR THIS CORNER

B. Description of corner evidence found and/or method applied in restoring or reestablishing corner:

FOUND 3/4" PIPE IN LINE WITH TREE/FENCE LINE NORTH. TRAVERSE 1/2 MILE EAST AND 2 1/2 MILES WEST CONFIRM FOUND 3/4" PIPE IS ON TOWN LINE AND FITS VERY WELL WITH OLD TREE/FENCE LINE OCCUPATION TO THE NORTH.
ACCEPTED FOUND PIPE AS BEST EVIDENCE OF CORNER POSITION.
REPLACED 3/4" PIPE WITH STANDARD BARRY COUNTY REMONUMENTATION MONUMENT.

ACT 345 BARRY COUNTY REMONUMENTATION
APPROVED BY PEER REVIEW AT A MEETING HELD ON

APRIL 10, 1995 TR
BRIAN REYNOLDS COUNTY SURVEYOR

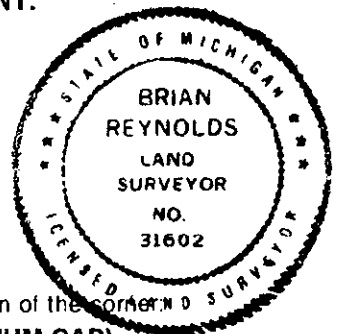

C. Description of monument for corner and accessories established to perpetuate locating the position of the corner:

SET STANDARD BARRY COUNTY REMONUMENTATION MONUMENT (3/4"X36"W/ALUMINUM CAP)
SET 40d NAIL W/PLASTIC TAG IN THE EAST SIDE OF A 14" TWIN CHERRY SOUTH 54.34'
FOUND NAIL WITH CAP IN THE EAST SIDE OF A RAILROAD TIE FENCE POST S2°W 29.82'
SET 40d NAIL W/PLASTIC TAG IN THE SOUTH SIDE OF A UTILITY POLE N77°E 147.00'
SET 40d NAIL W/PLASTIC TAG IN THE WEST SIDE OF AN 8" ASPEN N24°W 61.28'
FOUND NAIL WITH CAP IN THE NORTHWEST SIDE OF A WOODEN FENCE POST S22°W 35.88'
L-1 T3N, R9W, RUTLAND TOWNSHIP WEST 11.75'

Signed by [Signature]
Surveyor's Michigan License No. 31602

Date AUGUST 16, 1996