

SURVEY & REMONUMENTATION

FEB 17 1998

SECTION

BARRY COUNTY REMONUMENTATION LAND CORNER RECORDATION CERTIFICATE Filing Requirement of Act 74, Mich. P.A. 1970

For corners in

Barry (County)

Located in: Irving Township

Corner Code #



2671 Page: 1 of 2 01/02/1998 07:49A

Sandy Schondelmayer - Barry Co. LCRCR

- 1. Public Land Survey T 4N R 9W M-1
Carlton Township T4N R8W A-1
2. Property Controlling in Section S T R
3. Miscellaneous Property in Sec. S T R
4. Lot No. Recorded Plat
5. Private Claims

Register of Deeds Stamp & File Number

Grid table with columns T4N, R8W and T4N, R9W, and rows 1-13. Contains numbers 1-36 in a grid pattern.

I, Robert Jonker, in a field survey on Dec. 5, 1997 do hereby state that under requirements of P.A. 74, Michigan P.A. of 1970, the corner points mentioned in lines 1 and 2 above were in conformance with regulations and the rules in the current manual of survey instructions of the United States Department of the Interior, Bureau of Land Management or by a decree of a Court of Law and/or that the corner points mentioned in lines 3, 4 and 5 above were in conformance with the rules of the Michigan Board of Land Surveyors or by a Decree of a Court of Law; established, re-established, monumented, recovered, found as expressed below:

NOTE: Not more than 2 corners, all in the same town and range, may be recorded on this certificate.


- A. Description of original monument and accessories and/or subsequent restoration:
GLO - 1826, L. Lyon D.S. L.C.R.C. #002 - 1971 Bill Rogers
Beech 22 - N35W 33 Nothing listed in part "A" or "B"
DO 18 - S43 1/2 E 39 Didn't say what was at corner
N45°E spk - p.pole 37'
N45°W spk - 18" Osage Orange 32.9'
Center of U.S.G.S. B.M. S45°W 42.65'
1895 - Bateman Road Comm. - 1971
Fd.-put iron & brick Same as Bill Rogers (above)
N45 1/2 E 77', 15" Apple
N37W, 33 2/3, 15" Mulberry

See over for L.C.R.C.'s from Kent County 1131, 1715, 7002 & 9603-A & B

- B. Description of corner evidence found and/or method applied in restoring or reestablishing corner:
Found Kent County Monument (Harrison) by witnesses listed for L.C.R.C. #9603-A & B

ACT 345 BARRY COUNTY REMONUMENTATION APPROVED BY PEER REVIEW AT A MEETING HELD ON 8 Dec. 97 BRIAN REYNOLDS COUNTY SURVEYOR

- C. Description of monument for corner and accessories established to perpetuate locating the position of the corner:
Harrison Mon.
Kent Co. Remon nail & tag on NW side P.Pole S60°W 56.52'
Kent Co. Remon nail & tag on N side G.Pole N33°W 39.10'
Kent Co. Remon nail & tag on SE side P.Pole N44°E 36.90'
C/L base of street sign post S63°E 48.3'
Top of NW cor. steel guard rail post S19°W 63.24'
@ C/L "X"

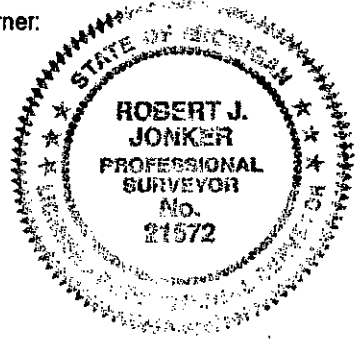

Signed by Robert J. Jonker
Surveyor's Michigan License No. 21572

Date Dec. 8, 1997

SURVEY &
REMONUMENTATION

FEB 17 1998

SECTION



2671

Page: 2 of 2
01/02/1998 07:49A

Sandy Schondelmayer - Barry Co. LCRCR

NOTE: M-1, T4N, R9W, is common with M-13, T5N, R9W.
The following L.C.R.C.'s have been recorded in Kent County for this corner.

LCRC #1131, 1978, Medema, VanKooten & Assoc.
Found 1 $\frac{1}{2}$ " round iron that agreed with the Kent Co. Wit. map.
Part "C" - took wit.
Spike W side 28" Oak SSE 131.55'
Spike SW side 26" Mulberry NW 33.46'
PK SE side p & t pole NE 36.88'

LCRC #1715, Williams & Works, 1981 - Also LCRC #1131 is listed
Part "A" - K.C.R.C. wit. map - 1944
18" Mulberry NW 33.05'
Cor. steel fe. post SE 27.2'
18" Elm ESE 123.9'
16" Oak SSE 130.75'
Cor. fe. post SW 36.6'

Part "B" - Found 1 $\frac{1}{2}$ " round iron & shear blades in stone pile by some of the wit.
listed in part "A" above.

Part "C" - Set K.C. Mon. & took wit.
Nail & K.C. Remon tag in SW side 24" Mulberry N40°W 33.39'
Nail & K.C. Remon tag in W side 31" Oak S10°E 131.54'
Nail & K.C. Remon tag in SE side 18" Pear S55°W 118.98'
Nail & K.C. Remon tag in S side 6" Maple N60°W 58.56'
Nail & K.C. Remon tag in E side 27" Mulberry N10°W 87.55'
Nail & K.C. Remon tag in W side 8" Cedar N40°E 40.75'
Nail & K.C. Remon tag in N side 12" Maple S80°E 126.13'
Set Mon. 3" under surface of gravel road N-S & E-W

LCRC #7002 - 1994 - Bill Byl
Part "A" - wit. listed in LCRC #1715
Part "B" - Found K.C. Mon.
Part "C" - took new wit.
Set nail & KC Remon tag SW side 32" Mulberry N40°W 33.39'
Nail & KC remon tag W side 31" Oak stump S10°E 131.57'
Set nail & KC remon tag S side 12" Maple N60°W 58.5'
Set nail & KC Remon tag E side 30" Mulberry N10°W 87.55'
Set nail & KC Remon tag W side 12" Cedar N40°E 40.75'
Set nail & KC Remon tag N side 18" Maple S80°E 126.13'

LCRC #9603 - A & B, Fall - 1996, Jonker L.S.
Part "A" - wit. listed for LCRC #1131, 7002 & 1715
Part "B" - Spring of 1996 - took wit. prior to construction
Fall 1996, set new Harrison Mon. by construction witnesses
Part "C" - Harrison Mon.
Kent Co. remon nail & tag on NW side P.Pole S60°W 56.52'
Kent Co. remon nail & tag on N side G.Pole N33°W 39.10'
Kent Co. remon nail & tag on SE side P.Pole N44°E 36.90'
C/L base of street sign post S63°E 48.3'
Top of NW cor. steel guard rail post S19°W 63.24'
@ C/L "X"