

OCT 27 1994

COMMISSION

BARRY COUNTY REMONUMENTATION
LAND CORNER RECORDATION CERTIFICATE
Filing Requirement of Act 74, Mich. P.A. 1970

STATE OF MICHIGAN
COUNTY OF BARRY
RECEIVED FOR RECORD

SEP 26 11 21 AM '94

Sandy Schondelmayer
REGISTER OF DEEDS

002214

Register of Deeds Stamp & File Number

For corners in

BARRY

(County)

Located In:

Corner Code #/

- 1. Public Land Survey T 4N R 9W M-8
IRVING TOWNSHIP T R
E 1/4COR SEC 24 ON RANGE LINE R
- 2. Property Controlling S T R
in Section S T R
- 3. Miscellaneous S T R
Property in Sec. S T R

- 4. Lot No. _____, Recorded Plat _____
- 5. Private Claims _____

| | A | B | C | D | E | F | G | H | I | J | K | L | M |
|----|----|----|----|----|----|----|---|---|---|---|---|---|---|
| 2 | 6 | 5 | 4 | 3 | 2 | 1 | | | | | | | |
| 3 | | | | | | | | | | | | | |
| 4 | 7 | 8 | 9 | 10 | 11 | 12 | | | | | | | |
| 5 | | | | | | | | | | | | | |
| 6 | 18 | 17 | 16 | 15 | 14 | 13 | | | | | | | |
| 7 | | | | | | | | | | | | | |
| 8 | 19 | 20 | 21 | 22 | 23 | 24 | | | | | | | |
| 9 | | | | | | | | | | | | | |
| 10 | 30 | 29 | 28 | 27 | 26 | 25 | | | | | | | |
| 11 | | | | | | | | | | | | | |
| 12 | 31 | 32 | 33 | 34 | 35 | 36 | | | | | | | |
| 13 | | | | | | | | | | | | | |

I, BRIAN REYNOLDS, in a field survey on 8 SEPT, 1994

do hereby certify that under requirements of P.A. 74, Michigan P.A. of 1970, the corner points mentioned in lines 1 and 2 above were in conformance with regulations and rules therefore as required in the current manual of survey instructions of the United States Department of the Interior, Bureau of Land Management or by a decree of a Court of Law and/or that the corner points mentioned in lines 3, 4 and 5 above were in conformance with the rules of the Michigan Board of Land Surveyors or by a Decree of a Court of Law; established, re-established, monumented, re-monumented, recovered, found as expressed below:

NOTE: Not more than 4 corners, all in the same town and range, may be recorded on this certificate.

A. Description of original monument and accessories and/or subsequent restoration:

- 1. CORNER ESTABLISHED BY GENERAL LAND OFFICE DEPUTY SURVEYOR LUCIUS LYON, 1826. W. OAK 24 S52W 60 Do 28 N37 1/2W 74
- 2. NO RECORD OF CORNER IN COUNTY SURVEYOR RECORDS OR THE RECORDS, PLANS OR NOTES OF THE COUNTY ROAD COMMISSION
- 3. UNRECORDED SURVEY BY MARINUS MULDER, c1985, SET OR USED IRON PIPE, NO WITNESSES AVAILABLE
- 4. UNRECORDED SURVEY BY BRIAN REYNOLDS, P.S. #31602, 1992, FOUND IRON PIPE, NO WITNESSES RECORDED

B. Description of corner evidence found and/or method applied in restoring or reestablishing corner:

FOUND 3/4" PIPE, 18" LONG, ABOUT ONE FOOT BELOW THE SURFACE OF THE GRAVEL ROAD

**ACCEPTED FOUND PIPE AS BEST AVAILABLE EVIDENCE OF CORNER LOCATION
REPLACED 3/4" PIPE WITH STANDARD BARRY COUNTY REMON IRON AND CAP**


ACT 345 BARRY COUNTY REMONUMENTATION
APPROVED BY PEER REVIEW AT A MEETING HELD ON

12 SEPT '94 BR
BRIAN REYNOLDS COUNTY SURVEYOR

C. Description of monument for corner and accessories established to perpetuate locating the position of the corner:

SET STANDARD BARRY COUNTY REMONUMENTATION IRON (3/4"X36"W/ALUMINUM CAP)

- SET 40d NAIL W/REMON TAG IN SE SIDE OF A 14" MAPLE, S40W, 54.56'
- SET 40d NAIL W/REMON TAG IN W SIDE OF A 12" MAPLE, S24E, 78.54'
- SET 40d NAIL W/REMON TAG IN SW SIDE OF UTILITY POLE, S59E, 78.29'
- SET 40d NAIL W/REMON TAG IN N SIDE OF A 12" BLACK WALNUT, S44E, 55.09'
- SET 40d NAIL W/REMON TAG IN NE SIDE OF A 12" BLACK WALNUT, N72E, 41.16'
- APPROXIMATELY ON CENTER OF GRAVEL ROAD N-S (FIGHTER ROAD)
IN LINE WITH TREE ROW WEST

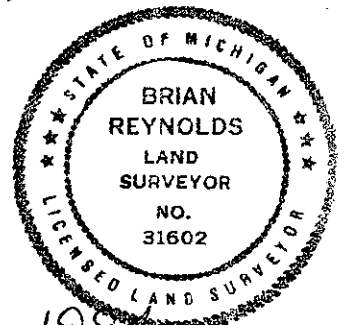

Signed by [Signature]

Date SEPT 14, 1994

Surveyor's Michigan License No. 31602