

FEB 03 1999

LAND CORNER RECORDATION CERTIFICATE  
Filing Requirement of Act 74, Mich. P.A. 1970

SECTION

For Corners in  
**BARRY**  
(county)

Located In:

Corner Code #



**2692**  
Page: 1 of 1  
10/26/1998 10:57A

Sandy Schondeimayer - Barry Co. LCRGR

- 1. Public Land Survey T 4N R 9W M-11  
CORNER COMMON TO T \_\_\_\_\_ R \_\_\_\_\_  
SECTIONS 25 & 36 T \_\_\_\_\_ R \_\_\_\_\_  
ON RANGE LINE T \_\_\_\_\_ R \_\_\_\_\_  
IRVING TOWNSHIP
- 2. Property Controlling S \_\_\_\_\_ T \_\_\_\_\_ R \_\_\_\_\_  
in Section S \_\_\_\_\_ T \_\_\_\_\_ R \_\_\_\_\_
- 3. Miscellaneous S \_\_\_\_\_ T \_\_\_\_\_ R \_\_\_\_\_
- 4. Lot No \_\_\_\_\_ Recorded Plat \_\_\_\_\_
- 5. Private Claims \_\_\_\_\_

Register of Deeds Stamp & File Number

I, Brian Reynolds, in a field survey on 23 APRIL, 1997 do hereby certify that under requirements of P.A. 74, Michigan P.A. of 1970, the corner points mentioned in lines 1 and 2 above were in conformance with regulations and rules therefore as required in the current manual of survey instructions of the United States Department of the Interior, Bureau of Land Management or by a decree of a Court of Law and/or that the corner points mentioned in lines 3, 4, and 5 above were in conformance with the rules of the Michigan Board of Land Surveyors or by a Decree of a Court of Law; established, re-established, monumented, re-monumented, recovered, found as expressed below.

NOTE: Not more than 2 corners, all in the same town and range, may be recorded on this certificate.

	A	B	C	D	E	F	G	H	I	J	K	L	M
1													
2	6		5		4		3		2		1		
3													
4	7		8		9		10		11		12		
5													
6	18		17		16		15		14		13		
7													
8	19		20		21		22		23		24		
9													
10	30		29		28		27		26		25		
11													
12	31		32		33		34		35		36		
13													


- A. Description of original monument and accessories and/or subsequent restoration:
- 1. GENERAL LAND OFFICE: L. LYON, D.S., 1826 (R9W, P. 150) ELM 18 N84½ W 166 W. O. 6 S1½ W ??
  - 2. COUNTY SURVEYOR RECORDS: FRANK S. BOWEN, 1875 (L.1, P.96) "FOUND ONE GOV'T BEARING" NO WITNESSES GIVEN
  - 3. ALSO: LEE S. COBB, 1889 (L.2, P. 269) & (BOOK IX, P. 43) "FOUND ONE GOV'T BEARING FOR IRVING, PUT IN STONE 16 x 10 x 8 GLASS & CROCKERY" NO WITNESSES GIVEN
  - 4. LAND CORNER RECORDATION CERTIFICATE: #413, BY BRIAN REYNOLDS, P. S. #31602, 1981 "FOUND FENCE CORNER ON EAST SIDE OF "CAUSEWAY" FENCES SOUTH AND EAST, EXCAVATED TO WATER TABLE SEVERAL FEET AROUND, NO STONE FOUND. ACCEPTED FENCE CORNER AS SECTION CORNER, SET ½" CAPPED IRON" 6" ELM S20°E 27.04' 60" WILLOW WEST 26.94' ½" CAPPED IRON NORTH 12.54' 10'+/- EAST OF CENTERLINE ABANDONED ROADWAY.

\*\*\* NO OTHER HISTORICAL INFORMATION, PUBLIC OR PRIVATE, AVAILABLE FOR THIS CORNER \*\*\*

B. Description of corner evidence found and/or method applied in restoring or reestablishing corner:  
FOUND IRON & ALL WITNESSES BY REYNOLDS (#4 ABOVE).  
ACCEPTED IRON BY REYNOLDS AS BEST AVAILABLE EVIDENCE OF CORNER POSITION.  
SET STANDARD BARRY COUNTY REMONUMENTATION MONUMENT.

C. Description of monument for corner and accessories established to perpetuate locating the position of the corner:  
SET STANDARD BARRY COUNTY REMONUMENTATION MONUMENT (3/4" X 36" IRON) WITH ALUMINUM CAP.  
FOUND 20d NAIL IN THE NORTHEAST SIDE OF A 6" ELM S20°E 27.05'  
FOUND 20d NAIL IN THE NORTH SIDE OF A 60" WILLOW S89°W 26.93'  
SET 20d NAIL IN THE NORTHEAST SIDE OF A 12" ASH N60°W 22.53'  
½" CAPPED IRON (A-11, T4N, R8W) (REYNOLDS #31602) NORTH 12.54'  
10'+/- EAST OF CENTERLINE OF ABANDONED NORTH-SOUTH ROAD  
ROUGHLY IN LINE W/DECAYING FENCES SOUTH & EAST

ACT 345 BARRY COUNTY REMONUMENTATION  
APPROVED BY PEER REVIEW AT A MEETING HELD ON  
8 Sept. '97 ISR  
BRIAN REYNOLDS COUNTY SURVEYOR

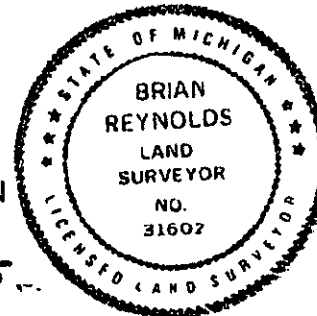

Signed by [Signature]  
Surveyor's Michigan License No 31602

Date 10/19/1998