

SURVEY & REMONUMENTATION

BARRY COUNTY REMONUMENTATION

AUG 13 1998

LAND CORNER RECORDATION CERTIFICATE
Filing Requirement of Act 74, Mich. P.A. 1970

For Corners **SECTION**
BARRY
(county)

Located In:

Corner Code #



2681

Page: 1 of 1
04/23/1998 08:10

- 1. Public Land Survey T 4N R 9W M-12
- EAST 1/4 CORNER T R _____
- SECTION 36 T R _____
- IRVING TOWNSHIP T R _____
- ON RANGE LINE
- 2. Property Controlling S _____ T _____ R _____
in Section S _____ T _____ R _____
- 3. Miscellaneous S _____ T _____ R _____
Property in Sec. S _____ T _____ R _____

Sandy Schondelmayer - Barry Co. LCRCR

Register of Deeds Stamp & File Number _____

- 4. Lot No. _____, Recorded Plat _____
- 5. Private Claims _____

I, **Brian Reynolds**, in a field survey on **10 AUGUST, 1997** do hereby certify that under requirements of P.A. 74, Michigan P.A. of 1970, the corner points mentioned in lines 1 and 2 above were in conformance with regulations and rules therefore as required in the current manual of survey instructions of the United States Department of the Interior, Bureau of Land Management or by a decree of a Court of Law and/or that the corner points mentioned in lines 3, 4, and 5 above were in conformance with the rules of the Michigan Board of Land Surveyors or by a Decree of a Court of Law; established, re-established, monumented, re-monumented, recovered, found as expressed below.

	A	B	C	D	E	F	G	H	I	J	K	L	M
2	6	5	4	3	2	1							
3													
4	7	8	9	10	11	12							
5													
6	18	17	16	15	14	13							
7													
8	19	20	21	22	23	24							
9													
10	30	29	28	27	26	25							
11													
12	31	32	33	34	35	36							
13													

NOTE: Not more than 2 corners, all in the same town and range, may be recorded on this certificate.

A. Description of original monument and accessories and/or subsequent restoration:

- 1. GENERAL LAND OFFICE: L. LYON, D.S., 1826 (R9W, P.150) B. O. 22 S7 1/2W 164 W. O. 22 N85 1/2W 235
- 2. LAND CORNER RECORDATION CERTIFICATE: #413, BY BRIAN REYNOLDS, P.S. #31602, MARCH 1990 "NO LOCAL EVIDENCE FOUND. SET EQUIDISTANT AND ON LINE BETWEEN M-11 AND M-13" RAILROAD SPIKE NAIL & CAP IN FENCE CORNER POST S10°E 21.19' N&C IN W'LY GATE POST N15°W 61.68' 5.5' W OF FENCE SOUT RAILROAD SPIKE NORTH 6.27'

***** NO OTHER HISTORICAL INFORMATION, PUBLIC OR PRIVATE, AVAILABLE FOR THIS CORNER *****


B. Description of corner evidence found and/or method applied in restoring or reestablishing corner:

FOUND WITNESS SPIKES IN FENCE CORNER POST AND IN GATE POST; HOWEVER RAILROAD SPIKE MONUMENTS FOR M-12 AND FOR A-12 T4N, R8W, WERE BOTH REMOVED BY ROAD CONSTRUCTION. REMAINING WITNESSES DEFINED CORNER POSITION WELL NORTH-SOUTH, BUT NOT EAST-WEST. RE-ESTABLISHED CORNER POSITION FROM 1990 TRAVERSE.
INSTALLED STANDARD BARRY COUNTY REMONUMENTATION MONUMENT AND INSTALLED MONUMENT BOX.

C. Description of monument for corner and accessories established to perpetuate locating the position of the corner:
SET STANDARD BARRY COUNTY REMONUMENTATION MONUMENT (3/4" X 36" IRON) WITH ALUMINUM CAP.
FOUND NAIL W/CAP IN THE WEST SIDE OF A WOODEN GATE POST N15°W 61.75'
FOUND NAIL W/CAP IN THE EAST SIDE OF A WOODEN FENCE CORNER POST S10°E 21.10'
SET 20d NAIL W/REMON TAG IN THE SOUTH SIDE OF A 6 MAPLE CLUSTER N72°W 113.46'
SET "PK" W/REMON TAG IN THE NORTH SIDE OF A UTILITY POLE S78°W 136.70'
TOP CENTER OF A PIPE FITTING IN A WOODEN FENCE POST S38°W 24.94'
11.5' +/- SOUTH OF CENTERLINE OF EAST-WEST BITUMINOUS ROADWAY
A-12 T3N, R8W, CARLTON TOWNSHIP LIES NORTH 6.27'

ACT 345 BARRY COUNTY REMONUMENTATION
APPROVED BY PEER REVIEW AT A MEETING HELD ON

8 Sept. '97 ISR
BRIAN REYNOLDS COUNTY SURVEYOR

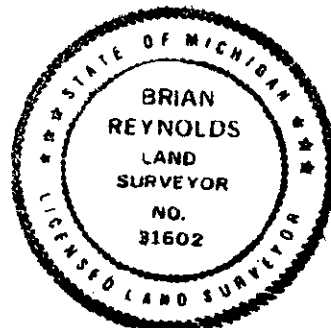

Signed by [Signature]
Surveyor's Michigan License No 31602

Date APRIL 20, 1998