

LAND CORNER RECORDATION CERTIFICATE

FILING REQUIREMENT OF ACT 74, MICH. P.A.1970

Thornapple Township, Barry Co., MI

FOR CORNERS OF:-	LOCATED IN-Sec. 24	CORNER CODE NUMBER
1. PUBLIC LAND SURVEY _____ T. <u>4</u> N. <u>X</u> R. <u>10</u> W. <u>X</u>		K-8, W $\frac{1}{2}$
2. PROPERTY CONTROLLING IN SECTION _____ T. _____ N. _____ S. R. _____ E. _____ W. _____		K-9, S.W. L-7, N $\frac{1}{2}$
3. MISCELLANEOUS PROPERTY IN SECTION _____ T. _____ N. _____ S. R. _____ E. _____ W. _____		M-7, N.E. 24 L-9, S $\frac{1}{2}$
4. LOT NO. _____, RECORDED PLAT _____		
5. PRIVATE CLAIMS _____		

No. 387

FILED
MAR 24 88
SANDY SCHONDELMAYER
BARRY COUNTY REGISTER OF DEEDS
AT 8:00 A M

REGISTER OF DEEDS STAMP AND
FILING NUMBER

I, Robert Jonker, do hereby certify that under requirements of P.A. 74, Michigan P.A. of 1970, the corner points mentioned in lines 1 and 2 above were, in a field survey on Jan. 6, 1988, established, re-established, monumented, re-monumented, recovered or restored as expressed below and in conformance with regulations and rules therefore as required in the current manual of survey instructions of the United States Department of the Interior, Bureau of Land Management or by a decree of a court of law. Furthermore, that the corner points mentioned in lines 3, 4 and 5 above were, in a field survey on _____, 19____, found, recovered, restored, established or re-established as expressed below and in conformance with the rules of the Michigan State Board of Registration for Land Surveyors or, by a Decree of a Court of law:

A. Description of original monument and accessories and/or subsequent restoration:

- K-8, LCRC #217, 1977, "T" iron.
- L-9, P.K. nail as recorded on survey in L-001, P. 764 & 765
- K-9, Pointed stone as recorded in L-001, P. 764 & 765.
- M-7, LCRC #298, 1980
- L-7, No info available

B. Description of corner evidence found and/or method applied in restoring or re-establishing corner:

- K-8, Fd. 1 $\frac{1}{2}$ " pipe over "T" iron per wit. for LCRC #217.
- L-9, Fd. P.K. nail per survey recorded in L-001, P. 764 & 765.
- K-9, Pointed stone per survey recorded in L-001, P. 764 & 765.
- M-7, Corner & all wit. destroyed during road reconstruction.
Reset corner by going $\frac{1}{2}$ mile N & S & setting corner halfway on line as per info. received from Exxel Eng.
- L-7, Set corner on Easterly extension of C/L of 10' trail from the West, on old fence & tree line to the North.


C. Description of monument for corner and accessories established to perpetuate locating the position of the corner:

- | | |
|--|---|
| <p>K-8, 1$\frac{1}{2}$" pipe over "T" iron.
Nail E. side 20" Oak SSW 6.9'
Nail W. side 20" Oak NNW 16.36'
Nail S. side 14" Pop. ENE 21.43'
L-9, P.K. Nail
Nail W. side cor. fe. post S45°W 47.37'
Nail W. side fe. post S45°E 47.78'
Nail W. side fe. post N35°W 45.13'</p> | <p>K-9, POINTED stone at fe. corner.
Sq.spk. NE side 10" Map. S55°E 13.25'
Sq.spk. SE side 8" Map. S40°W 10.83'
Sq.spk. E. side 14" Sass. N10°E 7.09'</p> |
| <p>L-7, 1"x38" pipe
Spk. s. side 12" Oak N70°E 15.83', Spk. W. side 12" Oak S25°E 8.93'
Spk. S. side 12" Oak N70°W 9.47', Old E-W fence in trees, No. 5' ±</p> | <p>M-7, $\frac{1}{2}$" capped rerod.
Nail S. side 12" Oak N70°W 56.95'
Nail S. side 10" Tw. Oak S60°W 64.67'
P.K. nail S. side pipe pole N90°00'E 94.25'
<i>ON C/L 2 TRACK TO WEST</i></p> |

SIGNED BY Robert J. Jonker DATE 1-18-88
JONKER LAND SURVEYS
SURVEYOR'S MICHIGAN REGISTRATION NO. #21572

FOR STATE AND UNITED STATES AGENCIES:

SIGNED BY _____ DATE _____
CHIEF OF SURVEY PARTY
APPROVED AND SIGNED BY _____ DATE _____
MICHIGAN REGISTERED LAND SURVEYOR

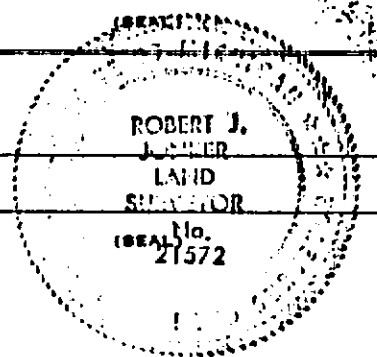

SURVEYOR'S MICHIGAN REGISTRATION NO. _____