

LAND CORNER RECORDATION CERTIFICATE

FILING REQUIREMENT OF ACT 74, MICH. P.A.1970

FOR CORNERS OF--:	LOCATED IN--:	CORNER CODE NUMBER
1. PUBLIC LAND SURVEY _____	T. <u>4N</u> N. <u>10W</u> E. _____ S., R. _____ W. _____	M-6, M-7, M-8
2. PROPERTY CONTROLLING IN SECTION _____	T. _____ N. _____ E. _____ S., R. _____ W. _____	
3. MISCELLANEOUS PROPERTY IN SECTION _____	T. _____ N. _____ E. _____ S., R. _____ W. _____	
4. LOT NO. _____, RECORDED PLAT _____		
5. PRIVATE CLAIMS _____		

NO. 298

FILED

MAY 22 1980

HOWARD J. FERRIS
Barry County Register of Deeds
At 2:17 P M.

REGISTER OF DEEDS STAMP AND FILING NUMBER

I, Douglas W. Bonnema, do hereby certify that under requirements of P.A. 74, Michigan P.A. of 1970, the corner points mentioned in lines 1 and 2 above were, in a field survey on February 6, 1980, established, re-established, monumented, re-monumented, recovered or restored as expressed below and in conformance with regulations and rules therefore as required in the current manual of survey instructions of the United States Department of the Interior, Bureau of Land Management or by a decree of a court of law. Furthermore, that the corner points mentioned in lines 3, 4 and 5 above were, in a field survey on _____, 19____, found, recovered, restored, established or re-established as expressed below and in conformance with the rules of the Michigan State Board of Registration for Land Surveyors or, by a Decree of a Court of law:

A. Description of original monument and accessories and/or subsequent restoration:

Get to record surveyor calls for stone monumenting pages

B. Description of corner evidence found and/or method applied in restoring or re-establishing corner:

M-6 Set capped iron. M-7 Set capped iron. M-8 Set capped iron on & gravel to N & S and on line with fence to West. Fence to East is 15' South.

* To set the government corners between NE corner of Section 12 and the E 1/4 corner of Section 24, we held a straight line for the 2 1/2 miles and divided distance into five equal parts.


<u>E 1/4 13</u>	<u>SE 13 / NE 24</u>	<u>E 1/4 24</u>
C. Description of monument for corner and accessories established to perpetuate locating the position of the corner:		
M-6 Capped iron.	M-7 Capped iron.	M-8 Capped iron.
Spike in sde 12" Tw. Oak	Spike in sde 14" Oak	Spike in sde 38" Oak } <i>old ties say 33.5'</i>
North 7.40'	N75°W 35.13' <i>cut</i>	N85°W 37.73'
Spike in sde 12" Oak	Spike in sde 10" Oak	Spike in sde 14" Hickory
S80°W 13.72'	S35°W 41.73' <i>cut</i>	NW 65.63'
Spike in sde 8" Oak	Spike in sde 22" Oak	Spike in sde 36" Maple
East 55.04'	SE 65.67' <i>cut</i>	NE 31.65'
Spike in sde 16" Oak	Spike in sde 12" Oak	Spike in sde 34" Maple
SE 42.75'	NE 20.40' <i>cut</i>	SE 38.04' <i>old ties 40.4'</i>
† Robertson E 15'+	† Robertson E 1'+	
	† rd to East S 40'+	

SIGNED BY Douglas W. Bonnema DATE March 18, 1980
EXCEL ENGINEERING, INC.

FOR STATE AND UNITED STATES AGENCIES:

SIGNED BY Douglas W. Bonnema DATE _____
CHIEF OF SURVEY PARTY

APPROVED AND SIGNED BY _____ DATE _____
MICHIGAN REGISTERED LAND SURVEYOR

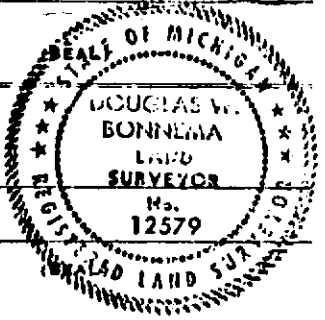

SURVEYOR'S MICHIGAN REGISTRATION NO. _____