

LAND CORNER RECORDATION CERTIFICATE
Filing Requirement of Act 74, Mich. P.A. 1970

For corners in
BARRY

(County)	Located In:	Corner Code #
1. Public Land Survey	T 4N R 10W	N-8
	T 4N R 10W	K-7
	T _____ R _____	_____
	T _____ R _____	_____
2. Property Controlling In Section	S _____ T _____ R _____	_____
	S _____ T _____ R _____	_____
3. Miscellaneous Property in Sec.	S _____ T _____ R _____	_____
	S _____ T _____ R _____	_____

Register of Deeds Stamp & File Number

4. Lot No. _____, Recorded Plat _____
 5. Private Claims _____

A	B	C	D	E	F	G	H	I	J	K	L	M
2	8	5	4	3	2	1						
3												
4	7	8	9	10	11	12						
5												
6	16	17	16	15	14	13						
7												
8	19	20	21	22	23	24						
9												
10	30	29	28	27	26	25						
11												
12	31	32	33	34	35	36						
13												

I, GARY C. BILOW, in a field survey on AUGUST 29, 19 90, do hereby certify that under requirements of P.A. 74, Michigan P.A. of 1970, the corner points mentioned in lines 1 and 2 above were in conformance with regulations and rules therefore as required in the current manual of survey instructions of the United States Department of the Interior, Bureau of Land Management or by a decree of a Court of Law and/or that the corner points mentioned in lines 3, 4 and 5 above were in conformance with the rules of the Michigan Board of Land Surveyors or by a Decree of a Court of Law; established, re-established, monumented, re-monumented, recovered, found as expressed below:

NOTE: Not more than 4 corners, all in the same town and range, may be recorded on this certificate.

A. Description of original monument and accessories and/or subsequent restoration:

(N-8) CORNER POST ESTABLISHED IN 1826 BY U.S. GOVERNMENT DEPUTY SURVEYOR LUCTUS LYON. ACCESSORIES: B. OAK 28 S09W 94, W. OAK 6 N15W 62. BARRY COUNTY SURVEYOR COBB STATES IN 1893 COUNTY SURVEYOR RECORD CONCERNING N-8: "E1/4 SEC. COR. FOUND FROM E1/4 POST OF SECTION 19 IRVING. SET STONE 30°14'112" AND BRICK. SUGAR 8° N47-3/4E 50. ". COUNTY ROAD COMMISSION RECORDS SHOW STONE, 34° MAPLE N45E 31.8', 30° MAPLE S45E 40.4', 32° OAK S88W 33.3'.

(K-7) CORNER PREVIOUSLY RECORDED UNDER ACT 74, P.A. 1970 BY DOUGLAS W. BONNEMA IN 1976 AS "FOUND SQUARE SPIKE, CHECKS WITH NIT'S BY M&M". BONNEMA'S ACCESSORIES ARE AS FOLLOWS: NAIL IN SDE 12" OAK SW 55.65', NAIL IN SDE DBL 18" OAK ESE 53.47', ON TREE LINE TO N-S.

B. Description of corner evidence found and/or method applied in restoring or reestablishing corner:

(N-8) ORIGINAL CORNER POST AND ACCESSORIES NOT RECOVERED. FOUND AND ACCEPTED POINTED STONE 22°17'112" AND RED BRICK APPROXIMATELY 6" BELOW THE GRAVEL SURFACE OF ROBERTSON ROAD. COUNTY SURVEYOR TIE TO MAPLE CHECKS TO A 42° MAPLE BUT BEARING WAS OBSERVED AS N58E. ROAD COMMISSION TIES TO MAPLES CHECK TO FACES OF 42° AND 36° MAPLES AFTER ALLOWING FOR TREE GROWTH.


THIS CORNER IS IN CONFLICT WITH A CORNER SET IN 1980 AS N-8 AND RECORDED ON LCRC 8298.

(K-7) FOUND SQUARE SPIKE IN ASPHALT PAVEMENT. BONNEMA'S TIE TO OAK ESE CHECKS TO REMAINS OF OLD OAK STUMP AT RECORD DISTANCE. TREE LINE IS ILL-DEFINED. OAK SW NOT FOUND.

C. Description of monument for corner and accessories established to perpetuate locating the position of the corner:

(N-8) FOUND POINTED STONE AND BRICK	(K-7) FOUND SQUARE SPIKE
N79W 34.05' SET SPIKE IN N. FACE 44° OAK	S60W 55.22' SET NAIL AND MICHIGAN DEPT. OF NATURAL
N21W 63.56' SET NAIL IN NE FACE 18° HICKORY	NATURAL RESOURCES TAG IN N. FACE 17° OAK
N58E 33.24' SET NAIL AND MDNR TAG S. FACE 42° MAPLE	N43W 33.56' SET NAIL AND MDNR TAG SW FACE POWER POLE
S44E 41.08' FND SPIKE IN SW FACE 36° MAPLE	N01E 29.90' SOUTH FACE OF METAL FENCE POST
S33W 49.35' SET NAIL AND MDNR TAG N. FACE 8° MAPLE	S10W 21.51' SET NAIL AND MDNR TAG E. FACE 8° POPLAR
S81E 3.79' FOUND 1/2" IRON BAR PREVIOUSLY RECORDED AS N-8	
S02E 15.01' FOUND POINTED STONE AT W1/4 CORNER SECTION 19, T4N-R9W.	

Signed by Gary C. Bilow
 Surveyor's Michigan License No. 26453

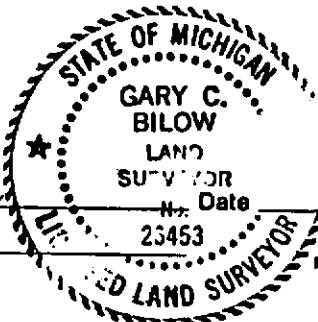

2/15/91