

APR 08 1996

Barry County Remonumentation

STATE OF MICHIGAN  
COUNTY OF BARRY  
RECEIVED FOR RECORD

Nov 20 8 35 AM '95

COMMISSION

LAND CORNER RECORDATION CERTIFICATE  
Filing Requirement of Act 74, Mich. P.A. 1970

Sandy Schindelmarzen

REGISTER OF DEEDS

002319

Register of Deeds Stamp & File Number

For corners in

Barry (County)	Located In:	Corner Code #
	4N 10W	A-5(SW, 7)
1. Public Land Survey	T ___ R ___	Thornapple Twp. ___
	T ___ R ___	___
	T ___ R ___	___
	T ___ R ___	___
2. Property Controlling in Section	S ___ T ___ R ___	___
	S ___ T ___ R ___	___
3. Miscellaneous Property in Sec.	S ___ T ___ R ___	___
	S ___ T ___ R ___	___
4. Lot No. _____, Recorded Plat _____		
5. Private Claims _____		

I, Steven Koerber, in a field survey on August 31, 19 95, do hereby certify that under requirements of P.A. 74, Michigan P.A. of 1970, the corner points mentioned in lines 1 and 2 above were in conformance with regulations and rules therefore as required in the current manual of survey instructions of the United States Department of the Interior, Bureau of Land Management or by a decree of a Court of Law and/or that the corner points mentioned in lines 3, 4 and 5 above were in conformance with the rules of the Michigan Board of Land Surveyors or by a Decree of a Court of Law; established, re-established, monumented, re-monumented, recovered, found as expressed below:

**NOTE: Not more than 4 corners, all in the same town and range, may be recorded on this certificate.**

	A	B	C	D	E	F	G	H	I	J	K	L	M
2	6	5	4	3	2	1							
3													
4	7	8	9	10	11	12							
5													
6	18	17	16	15	14	13							
7													
8	19	20	21	22	23	24							
9													
10	30	29	28	27	26	25							
11													
12	31	32	33	34	35	36							
13													

A. Description of original monument and accessories and/or subsequent restoration:

- A-5  
 GLO Sylvester Sibley DS, 1830  
 Witness to post set by Lucius Lyon, DS 1826  
 B. Ash 7 S 30 W 44  
 Beech 6 N 33W 21  
 (additional info. see back of sheet)
1. April 5, 1972 LCRC No. 26 (Barry County)  
 Recorded by Douglas Bonnema  
 Set 3/4" Iron pipe on line with centerline of gravel to West and fence and tree line to East, centerline of Blacktop to South is 8' East.  
 Nail in face 18" W. Cherry NW 47.22'  
 Nail in face 10" W. Cherry W-NW 73.27'  
 Nail in face of P. pole SW 74.10'  
 Nail in face of 40" Maple E-SE 56.43

B. Description of corner evidence found and/or method applied in restoring or reestablishing corner:


- A-5 Found 3/4" Iron Pipe  
 Found PK nail in N. side P. pole S55°W 74.15'  
 Found Spike in S. side 24" Maple N35°W 47.51'  
 Found spike in E. side 16" Elm N10°W 114.44'  
 Found spike in N. side 8" Ash S50°E 45.67'  
 C/L bit. road East 7.2'

ACT 345 BARRY COUNTY REMONUMENTATION  
 APPROVED BY PEER REVIEW AT A MEETING HELD ON  
August 14, 1995 BR  
 BRIAN REYNOLDS COUNTY SURVEYOR

C. Description of monument for corner and accessories established to perpetuate locating the position of the corner:

- A-5 Replaced 3/4" Iron Pipe with Standard Allegan Co. Mon. ( 3/4" x 24" Iron Rod with cap)
- |   |         |         |
|---|---------|---------|
| Set PK nail & Allegan Co. Remon. Tag in S. side P. Pole | N 80° W | 287.42' |
| Set PK nail & Allegan Co. Remon. Tag in NW side P. Pole | N 45° E | 174.06' |
| Set nail & Allegan Co. Remon. Tag in N. side 24" Oak    | N 90° E | 154.55' |
| Set 1/2" Rerod  | N 80° E | 150.00' |
| Stop sign post  | S 80° W | 53.3'   |
- C/L N-S bit road  
 A-5 corner is a common corner with M-5 Leighton Township, Allegan County.

Signed by Steven C. Koerber Date 11-13-1995  
 Surveyor's Michigan License No. 39085

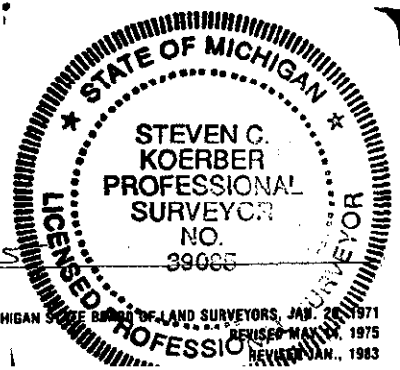

2. April 27, 1972  
Barry Co. Rd. Comm  
Iron  
Guard Post N45°W 34.2'  
Guard Post S45°W 34.7'  
18" Cherry N40°W 47.3'  
30" Maple S45°E 56.5'  
8" Cherry N40°W 73.3'  
C/L Road 7.2' East of Sec. cor.
3. Sept. 16, 1982  
C.S. Hay & Assoc.  
Recorded Survey L. 1, Pg. 726 (Barry Co.)  
Found 3/4" I.P.  
Nail in E. side 18" W. Cherry NW 47.34'  
Nail in N. side 40" Maple ESE 57.56'  
N. edge Street sign SW 31.17'
4. Sept. 23, 1985  
Jonker Land Surveys  
Recorded Surveys L. 1, Pgs. 884-886 (Barry Co.)  
Found 3/4" I.P.  
Nail in 18" W. Cherry NW 47.34'  
Nail in 40" Maple ESE 57.56'  
N. Edge Street Sign SW 31.17'
5. July 1991  
MBN Eng./ Surv  
Recorded Survey L. 2, Pg. 44 (Barry Co.)  
Found 1" I.P. per LCRC 344
6. Dec. 2, 1993  
Exxel Eng.  
Recorded survey L. 2, Pg. 86 (Barry Co.)  
1/2" Rerod  
Nail in SW side C. Cherry N40°W 52.29'  
Dbl hd nail NE side 10" Ash S45°E 39.82'  
PK NW side P. pole S60°W 79.78'  
Dbl hd nail E. side 14" Elm N10°W 116.08'