

SURVEY & MONUMENTATION

Barry County Remonumentation

STATE OF MICHIGAN
COUNTY OF BARRY
RECEIVED FOR RECORD

APR 08 1996

LAND CORNER RECORDATION CERTIFICATE
Filing Requirement of Act 74, Mich. P.A. 1970

Nov 20 8 35 AM '95

For corners in **COMMISSION**

Sandy Schondelmar
REGISTER OF DEEDS

Barry (County)	Located In:	Corner Code #
1. Public Land Survey	4N 10W T _____ R _____ T _____ R _____ T _____ R _____ T _____ R _____	A-9(SW, 19) Thornapple Twp. _____ _____ _____
2. Property Controlling in Section	S _____ T _____ R _____ S _____ T _____ R _____	_____ _____
3. Miscellaneous Property in Sec.	S _____ T _____ R _____ S _____ T _____ R _____	_____ _____

002322

Register of Deeds Stamp & File Number

4. Lot No. _____, Recorded Plat _____
5. Private Claims _____

Steven Koerber August 31 1995

I, _____ in a field survey on _____, 19 _____, do hereby certify that under requirements of P.A. 74, Michigan P.A. of 1970, the corner points mentioned in lines 1 and 2 above were in conformance with regulations and rules therefore as required in the current manual of survey instructions of the United States Department of the Interior, Bureau of Land Management or by a decree of a Court of Law and/or that the corner points mentioned in lines 3, 4 and 5 above were in conformance with the rules of the Michigan Board of Land Surveyors or by a Decree of a Court of Law; established, re-established, monumented, re-monumented, recovered, found as expressed below:

	A	B	C	D	E	F	G	H	I	J	K	L	M
2	6	5	4	3	2	1							
3													
4	7	8	9	10	11	12							
5													
6	18	17	16	15	14	13							
7													
8	19	20	21	22	23	24							
9													
10	30	29	28	27	26	25							
11													
12	31	32	33	34	35	36							
13													

NOTE: Not more than 4 corners, all in the same town and range, may be recorded on this certificate.

A. Description of original monument and accessories and/or subsequent restoration:

A-9 GLO Sylvester Sibly DS, 1830
Corner is 13 links (8.58') North of Leighton Twp. corner
A W. Oak 18 S72E 35
Do 14 N43E 36

1. County Surveyor records April 1, 1875 Frank S. Bowen
Crockery around stake, Elm Stump 26 S67E 25

2. County Surveyor records Found old Stake & Crockery set stone 18x6x7 & brick, Lee Cobb 1890
Sugar 12 S37 3/4W 63 1/2, Hick 8 N251/4 W 90


B. Description of corner evidence found and/or method applied in restoring or reestablishing corner:

A-9 Found rered in mon. box
Found Square spike in N. side 33" Hickory 83.75'
C/L 24" Maple S65°W 81.6'
Found rered in Mon. box (M-9, Leighton Twp., Allegan Co.) corner is 8.56' South
Square spike in N. side 33" Hickory 83.75'

ACT 345 BARRY COUNTY REMONUMENTATION
APPROVED BY PEER REVIEW AT A MEETING HELD ON
AUGUST 14, 1995 BR
BRIAN REYNOLDS COUNTY SURVEYOR

C. Description of monument for corner and accessories established to perpetuate locating the position:

A-9 Replaced rered with Barry Co. Mon. (3/4" x 24" Iron Rod with cap)
Set nail & Allegan Co. Remon. Tag in S. side 33" Hickory N 70° W 83.92'
Set nail & Allegan Co. Remon. Tag in N. side 24" Maple S 70° W 82.10'
Set PK nail & Allegan Co. Remon. Tag in SW side P. Pole N 40°W 161.91'
Set PK Nail & Allegan Co. Remon. Tag in SE side P. Pole N 40° E 138.46'
SW corner house (plywood wall cor.) N 40° E 181.40'
Square spike in N. side 33" Hickory 83.75'
Allegan County Iron Rod with Remon cap in Mon. box (M-9, Leighton Twp., Allegan Co.) corner is 8.56' South

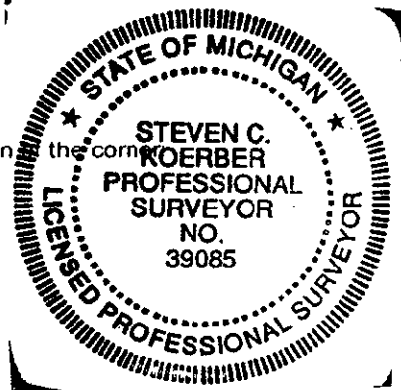

Signed by Steven C. Koerber Date 11-13-1995
Surveyor's Michigan License No. 39085

3. Barry Co. Rd. Comm.
Iron in C/L intersection
Nail in 10" Hickory S55°E 53.82'
Nail in 14" Maple S70°W 77.20'
Nail in 30" Oak N65°W 84.72'

4. Feb. 22, 1988
MVK recorded survey L.1, Pg. 914 & 903
1" square head bolt in mon. box
Square spike in N. side 30" Hickory W-NW 83.83'
Square spike in S. side 18" Maple W-SW 82.14'