

DEC 9 3 02 PM '93

Sandy Schindelmarer  
REGISTER OF DEEDS

Barry County Remon.  
LAND CORNER RECORDATION CERTIFICATE  
Filing Requirement of Act 74, Mich. P.A. 1970

002154

Register of Deeds Stamp & File Number

For corners in

Barry  
(County)

Located In: Thorn- Corner Code #  
apple Twp.

1. Public Land Survey

T 4N R 10W E-9

T R

T R

T R

T R

2. Property Controlling  
in Section

S T R

S T R

3. Miscellaneous  
Property in Sec.

S T R

S T R

4. Lot No. \_\_\_\_\_, Recorded Plat \_\_\_\_\_

5. Private Claims \_\_\_\_\_

	A	B	C	D	E	F	G	H	I	J	K	L	M
2	6		5		4		3		2		1		
3													
4	7		8		9		10		11		12		
5													
6	16		17		16		15		14		13		
7													
8	19		20		21		22		23		24		
9													
10	30		29		28		27		26		25		
11													
12	31		32		33		34		35		36		
13													

I, Robert Jonker, in a field survey on February 10, 1993, do hereby certify that under requirements of P.A. 74, Michigan P.A. of 1970, the corner points mentioned in lines 1 and 2 above were in conformance with regulations and rules therefore as required in the current manual of survey instructions of the United States Department of the Interior, Bureau of Land Management or by a decree of a Court of Law and/or that the corner points mentioned in lines 3, 4 and 5 above were in conformance with the rules of the Michigan Board of Land Surveyors or by a Decree of a Court of Law; established, re-established, monumented, re-monumented, recovered, found as expressed below:

NOTE: Not more than 4 corners, all in the same town and range, may be recorded on this certificate.

A. Description of original monument and accessories and/or subsequent restoration:

E-9, L.C.R.C. #262, Byle, 1979 - wit. on record per page 206

Found "T" Iron - took new witnesses

MBT pole NW 69.4'  
Fence post NNE 78.3'  
Fence post ENE 78.26'  
P. pole SE 56.55'

E-9, L.C.R.C. #206, Exxel, 1976, "T" Iron  
Nail side 34" Hickory NE 57.3'  
PK side P. pole NW 69.39'  
PK side P. pole SE 56.55'

Co. Rd. Comm. = No info.  
Co. Surveyor = No info.

B. Description of corner evidence found and/or method applied in restoring or reestablishing corner:

E-9, Found "T" Iron in Mon Box on C/L "X"

Found PK in NE'ly side P. pole S 30° E 56.43'  
Found PK in W. side P. pole N 25° W 69.42'  
Set PK in W. side 10" Pine S 15° E 88.63'  
SE cor hse fndn N 35° W 146.52'

Accepted as best evidence of corner location.

SURVEY &  
REMONUMENTATION


APR 05 1994

COMMISSION

C. Description of monument for corner and accessories established to perpetuate locating the position of the corner:

E-9, Replaced with 3/4"x24" std. Barry Co. Capped Monument on

Found PK in NE'ly side P. pole S 30° E 56.43'  
Found PK in W. side P. pole N 25° W 69.42'  
Set PK in W. side 10" pine S 15° E 88.63'  
SE corner house foundation N 35° W 146.52'  
on C/L "X"

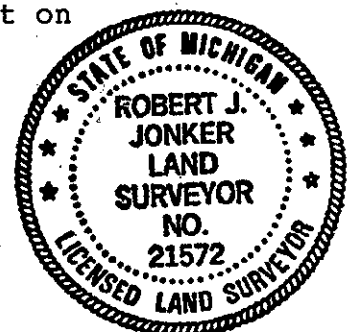

*Robert J. Jonker*

Signed by JONKER LAND SURVEYS  
Surveyor's Michigan License No. 21572

Date November 29, 1993