

Dec 9 3 02 PM '93

Sandy Schendelmayer
REGISTER OF DEEDS

Barry County Remon.
LAND CORNER RECORDATION CERTIFICATE
Filing Requirement of Act 74, Mich. P.A. 1970

002161

Register of Deeds Stamp & File Number

For corners in

Barry
(County)

Located in: Thorn-
apple Twp. Corner Code #
T 4N R 10W E-10
T R
T R
T R
S T R
S T R
S T R
S T R

1. Public Land Survey

2. Property Controlling
in Section

3. Miscellaneous
Property in Sec.

4. Lot No. Recorded Plat

5. Private Claims

	A	B	C	D	E	F	G	H	I	J	K	L	M
2	6	5	4	3	2	1							
3													
4	7	8	9	10	11	12							
5													
6	18	17	16	15	14	13							
7													
8	19	20	21	22	23	24							
9													
10	30	29	28	27	26	25							
11													
12	31	32	33	34	35	36							
13													

I, Robert Jonker, in a field survey on February 10, 19 93,
do hereby certify that under requirements of P.A. 74, Michigan P.A. of 1970, the corner points mentioned
in lines 1 and 2 above were in conformance with regulations and rules therefore as required in the
current manual of survey instructions of the United States Department of the Interior, Bureau of Land
Management or by a decree of a Court of Law and/or that the corner points mentioned in lines 3, 4 and 5
above were in conformance with the rules of the Michigan Board of Land Surveyors or by a Decree of a
Court of Law; established, re-established, monumented, re-monumented, recovered, found as
expressed below:

NOTE: Not more than 4 corners, all in the same town and range, may be recorded
on this certificate.

A. Description of original monument and accessories and/or subsequent restoration:

E-10, L. 1 of Surveys, P. 38 (King)
1/2" Iron Pipe
30" Maple N 40° E 56.52'
15" Maple N 85° E 46.0'

L.C.R.C. #356, Excell Eng. 1983
Found 1/2" rerod per King witnesses
Took new witnesses of:
Spk NW side 34" Maple N 40° E 56.4'
Spk S. side 16" Maple N 58° E 45.73'
Spk SW side 30" Walnut S 30° E 79.08'
Spk SW side 26" Maple N 40° W 83.62'

B. Description of corner evidence found and/or method applied in restoring or reestablishing corner:

E-10, Found 1/2" Rerod
Found Nail S. side 16" Maple N 85° E 45.75'
NW cor hse fndn N 65° E 118.61'
Set Nail E'ly side P. pole S 25° W 106.52'
Set Nail NE'ly side 24" Maple N 45° W 86.31'

Accepted as the best evidence of the corner location.


SURVEY &
REMONUMENTATION

APR 05 1994

COMMISSION

C. Description of monument for corner and accessories established to perpetuate locating the position of the corner:

E-10, Replaced with 3/4"x24" capped std. Barry Co. Mon.
Found Nail S. side 16" Maple N 85° E 45.75'
NW corner house foundation N 65° E 118.61'
Set Nail E'ly side P. pole S 25° W 106.52'
Set Nail NE'ly side 24" Maple N 45° W 86.31'
C/L gravel to West is 3' South
C/L N-S B.T. is 1' West

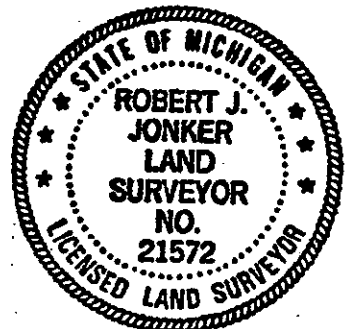

Robert J. Jonker

Signed by JONKER LAND SURVEYS
Surveyor's Michigan License No. 21572

Date November 29, 1993