

DEC 9 3 02 PM '93

Sandy Schondelmar
REGISTER OF DEEDS

Barry County Remon.
LAND CORNER RECORDATION CERTIFICATE
Filing Requirement of Act 74, Mich. P.A. 1970

For corners in

Barry
(County)

Located In: Thorn-
apple Corner Code #

- | | | | | | |
|------------------------------------|---|----|---|-----|------|
| 1. Public Land Survey | T | 4N | R | 10W | E-11 |
| | T | | R | | |
| | T | | R | | |
| | T | | R | | |
| 2. Property Controlling in Section | S | | T | | R |
| | S | | T | | R |
| 3. Miscellaneous Property in Sec. | S | | T | | R |
| | S | | T | | R |
4. Lot No. _____ Recorded Plat _____
5. Private Claims _____

002159

Register of Deeds Stamp & File Number

	A	B	C	D	E	F	G	H	I	J	K	L	M
2	6	5	4	3	2	1							
3													
4	7	8	9	10	11	12							
5													
6	18	17	16	15	14	13							
7													
8	19	20	21	22	23	24							
9													
10	30	29	28	27	26	25							
11													
12	31	32	33	34	35	36							
13													

I, Robert Jonker, in a field survey on February 10, 1993, do hereby certify that under requirements of P.A. 74, Michigan P.A. of 1970, the corner points mentioned in lines 1 and 2 above were in conformance with regulations and rules therefore as required in the current manual of survey instructions of the United States Department of the Interior, Bureau of Land Management or by a decree of a Court of Law and/or that the corner points mentioned in lines 3, 4 and 5 above were in conformance with the rules of the Michigan Board of Land Surveyors or by a Decree of a Court of Law; established, re-established, monumented, re-monumented, recovered, found as expressed below:

NOTE: Not more than 4 corners, all in the same town and range, may be recorded on this certificate.

A. Description of original monument and accessories and/or subsequent restoration:

E-11, Liber 1 of Surveys, P. 38 (King).

1/2" Iron pipe

20" Hickory S 35° E 74.4'

18" Catalpa S 35° W 61.24'

L.C.R.C. #356, Exxel Eng. 1983, Fd PK Nail

Sq. spk NW side 18" Catalpa S 35° W 61.24'

(stump)

Sq. spk W. side 20" Hickory S 35° E 74.4'

Exxel: set Capped Iron added wit. of:

C/L steel end fence post W. 32.97'
Sq. spk NW side 26" Oak NE 82.92'
Sq. spk W. side 23" Oak
N 20° E 75.13'

B. Description of corner evidence found and/or method applied in restoring or reestablishing corner:

E-11, Found Capped Iron - Top smashed

Fd Nail N. side 30" Oak N 45° E 82.92'

Fd Nail SW side 26" Oak S 20° E 74.42'

Set Nail E side 36" Oak S 20° W 129.03'

Set Nail S side 18" W. Cherry N 90° W 76.58'

Accepted as the best evidence of the corner location.

SURVEY &
REMONUMENTATION

APR 05 1994

COMMISSION

C. Description of monument for corner and accessories established to perpetuate locating the position of the corner:

E-11, Replaced with 3/4"x24" std. capped Barry Co. Monument


Found Nail N. side 30" Oak N 45° E 82.92'

Found Nail SW side 26" Oak S 20° E 74.42'

Set Nail E. side 36" Oak S 20° W 129.03'

Set nail S. side 18" W. Cherry N 90° W 76.58'

on C/L to N, S, E.

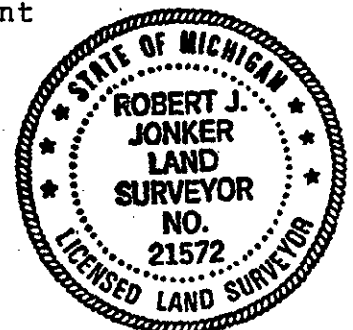

Robert J. Jonker

Signed by JONKER LAND SURVEYS

Date November 29, 1993

Surveyor's Michigan License No. 21572