

DEC 9 3 02 PM '93

Sandy Schendelmaier
REGISTER OF DEEDS

Barry County Remon.
LAND CORNER RECORDATION CERTIFICATE
Filing Requirement of Act 74, Mich. P.A. 1970

For corners in

Barry

(County)

Located In: Thorn- Corner Code #
apple Twp. F-9

1. Public Land Survey

T 4N R 10W F-9

T R

T R

T R

2. Property Controlling
in Section

S T R

S T R

3. Miscellaneous
Property in Sec.

S T R

S T R

4. Lot No. , Recorded Plat

5. Private Claims

002153

Register of Deeds Stamp & File Number

	A	B	C	D	E	F	G	H	I	J	K	L	M
2	6	5	4	3	2								
3													
4	7	8	9	10	11	12							
5													
6	18	17	16	15	14	13							
7													
8	19	20	21	22	23	24							
9													
10	30	29	28	27	26	25							
11													
12	31	32	33	34	35	36							
13													

I, Robert Jonker, in a field survey on February 10, 19 93, do hereby certify that under requirements of P.A. 74, Michigan P.A. of 1970, the corner points mentioned in lines 1 and 2 above were in conformance with regulations and rules therefore as required in the current manual of survey instructions of the United States Department of the Interior, Bureau of Land Management or by a decree of a Court of Law and/or that the corner points mentioned in lines 3, 4 and 5 above were in conformance with the rules of the Michigan Board of Land Surveyors or by a Decree of a Court of Law; established, re-established, monumented, re-monumented, recovered, found as expressed below:

NOTE: Not more than 4 corners, all in the same town and range, may be recorded on this certificate.

SURVEY &
REMONUMENTATION

APR 05 1994

COMMISSION

A. Description of original monument and accessories and/or subsequent restoration:

F-9, L.C.R.C. #262, Bill Byle, 1979

Found Boat Spike

MBT ENE 81.15' - out, 1193

P. pole ESE 154.02' - out, 1993

30" Elm SW 45.52' - out, 1993

B. Description of corner evidence found and/or method applied in restoring or reestablishing corner:

Found 1/2" Pin in Mon Box (over boat spike)

Found Nail N. side P. pole S 70° E 153.95'

Set PK S. side P. pole N 70° E 171.28'

Set PK in mail box post S 50° E 25.49'

SW cor brick garage corner N 20° E 177.28'

And is accepted as the best available evidence of the position of the original corner.

C. Description of monument for corner and accessories established to perpetuate locating the position of the corner:

F-9, Replaced with 3/4 x 24" capped standard Barry Co. Mon. in mon. box.

Found Nail N. side P. pole S 70° E 153.95'


Set PK S. side P. pole N 70° E 171.28'

Set PK in mail box post S 50° E 25.49'

SW cor brick garage corner N 20° E 177.28'

C/L E-W pavement is 2' North

No occupation N-S

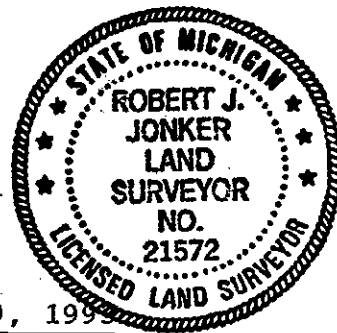

Robert J. Jonker

Signed by

Date November 29, 1993

JONKER LAND SURVEYS
Surveyor's Michigan License No. 21572