

APR 08 1996

BARRY COUNTY REMONUMENTATION

STATE OF MICHIGAN
COUNTY OF BARRY
RECEIVED FOR RECORD

DEC 15 2 07 PM '95

COMMISSION

LAND CORNER RECORDATION CERTIFICATE

Filing Requirement of Act 74, Mich. P.A. 1970

Sandy Schondelmarer

REGISTER OF DEEDS

For corners in

BARRY

(County)

Located In:


Corner Code #

1. Public Land Survey	T	<u>4N</u>	<u>R10W</u>	<u>G-3</u>
CORNER COMMON TO	T			
SECTIONS 3,4,9, &10	T			
THORNAPPLE TOWNSHIP	T			
2. Property Controlling	S			
in Section	S			
3. Miscellaneous	S			
Property in Sec.	S			

002340

Register of Deeds Stamp & File Number

- 4. Lot No. _____, Recorded Plat _____
- 5. Private Claims _____

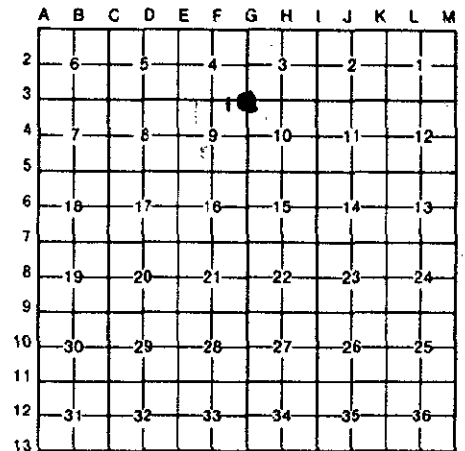

I, BRIAN REYNOLDS, in a field survey on 6 SEPT., 1995

do hereby certify that under requirements of P.A. 74, Michigan P.A. of 1970, the corner points mentioned in lines 1 and 2 above were in conformance with regulations and rules therelore as required in the current manual of survey instructions of the United States Department of the Interior, Bureau of Land Management or by a decree of a Court of Law and/or that the corner points mentioned in lines 3, 4 and 5 above were in conformance with the rules of the Michigan Board of Land Surveyors or by a Decree of a Court of Law; established, re-established, monumented, re-monumented, recovered, found as expressed below:

NOTE: Not more than 4 corners, all in the same town and range, may be recorded on this certificate.

A. Description of original monument and accessories and/or subsequent restoration:

GENERAL LAND OFFICE: SYLVESTER SIBLEY, D.S., 1830(R10W,P.173) A. SUGAR 28 N74E 35 A. BEECH 34 S61W
 COUNTY SURVEYOR RECORDS: COBB, MAY 4, 1892 (THORNAPPLE F.B.,P.86) "FOUND STONE AND EARTHEN"
 COUNTY ROAD COMMISSION: JAN. 4, 1972, "IRON" NAIL IN FACE OF P. POLE S-SW 102.13 T.POLE W 26.95
 20" WALNUT N-NE 47.97 12" WALNUT E-SE 21.61 C/L RD. S. 36'
 LAND CORNER RECORDATION CERTIFICATE: #230 BY D. BONNEMA, P.S. #12579, JAN. 1978 FOUND 3/4" IRON.
 CHECKS WITH BARRY COUNTY ROAD COMM. INFORMATION" PK IN SDE P.POLE ESE 77.13'
 PK IN SDE P.POLE ENE 84.23' SPIKE IN SDE 16" WILD CHERRY WNW 71.82' NE COR PORCH FNDN. SSW 128.56'
 ACT 132 SURVEYS: BY D. BONNEMA ALL RECITE THE SAME WITNESSES AS IN L.C.R.C.#230 ABOVE
 L.1,P.623; L.1,P.784; L.1,P.893-898; L.2,P.64

B. Description of corner evidence found and/or method applied in restoring or reestablishing corner:

FOUND 1/2" IRON (BONNEMA'S 3/4" IRON) FROM WITNESSES (P.POLE ENE, WILD CHERRY WNW & PORCH FDN.).
 ROAD COMMISSION WITNESSES ARE BELIEVED TO BE FOR A DIFFERENT CORNER.
 THEY DO NOT CONFORM TO ANYTHING IN THE FIELD.
 ACCEPTED FOUND 1/2" IRON AS BEST EVIDENCE OF CORNER POSITION.
 REPLACED 1/2" IRON WITH STANDARD BARRY COUNTY REMONUMENTATION MONUMENT.

ACT 345 BARRY COUNTY REMONUMENTATION
APPROVED BY PEER REVIEW AT A MEETING HELD ON

9/11/95 BR
BRIAN REYNOLDS COUNTY SURVEYOR

C. Description of monument for corner and accessories established to perpetuate locating the position of the corner:

SET STANDARD BARRY COUNTY REMONUMENTATION MONUMENT (3/4"X36"W/ALUMINUM CAP)
 SET 20d NAIL W/PLASTIC TAG IN THE EAST SIDE OF A 12" BLACK WALNUT S2°E 28.64'
 SET 20d NAIL W/PLASTIC TAG IN THE SOUTH SIDE OF A 14" CHERRY N62°W 72.14'
 FOUND "PK" IN THE NORTH SIDE OF A UTILITY POLE S69°E 77.24'
 FOUND "PK" IN THE SOUTH SIDE OF A UTILITY POLE N72°E 84.29'
 IN LINE WITH NORTH-SOUTH TREE LINE
 CENTERLINE EAST-WEST BITUMINOUS ROAD (PARMALEE) SOUTH 0.5'+/-



Signed by [Signature]
Surveyor's Michigan License No. 31602

Date 12/15/95