

Dec 9 3 02 PM '93

Barry County Remon.
LAND CORNER RECORDATION CERTIFICATE
Filing Requirement of Act 74, Mich. P.A. 1970

Sandy Schondelmayer

REGISTER OF DEEDS

002158

Register of Deeds Stamp & File Number


For corners in
Barry

(County)

Located In: Thorn-apple Corner Code #

1. Public Land Survey	T	4N	R	10W	G-9
	T		R		
	T		R		
	T		R		
2. Property Controlling in Section	S	T	R		
	S	T	R		
3. Miscellaneous Property in Sec.	S	T	R		
	S	T	R		

4. Lot No. _____ Recorded Plat _____
5. Private Claims _____

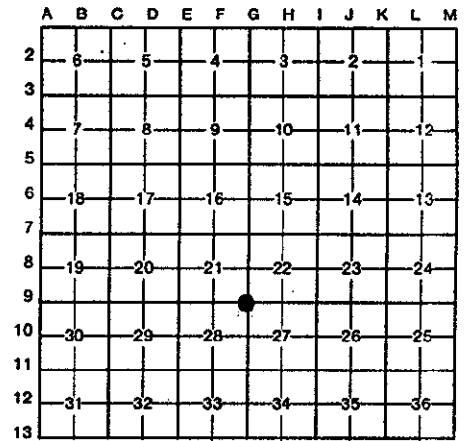

I, Robert Jonker in a field survey on February 10, 1993, do hereby certify that under requirements of P.A. 74, Michigan P.A. of 1970, the corner points mentioned in lines 1 and 2 above were in conformance with regulations and rules therefore as required in the current manual of survey instructions of the United States Department of the Interior, Bureau of Land Management or by a decree of a Court of Law and/or that the corner points mentioned in lines 3, 4 and 5 above were in conformance with the rules of the Michigan Board of Land Surveyors or by a Decree of a Court of Law; established, re-established, monumented, re-monumented, recovered, found as expressed below:

NOTE: Not more than 4 corners, all in the same town and range, may be recorded on this certificate.

A. Description of original monument and accessories and/or subsequent restoration:

L.C.R.C. #9, W & W, 1972, Iron	W & W Found boat spike by former wit. & took new wit.
NW cor hse SW 121.77'	
12" Maple 73.10'	Top center fire hydrant N 55° E 64.14'
SE cor hse NW 98.65'	N&T E. side C.P. pole S 33° E 49.43'
10" Elm NW 61.10'	N&T E. side 30" Oak S 12° W 94.42'
	Nail, face T. pole N 20° E 89.7'
	SE cor hse fndn N 40° W 98.57'

B. Description of corner evidence found and/or method applied in restoring or reestablishing corner:

Found Boat Spike

Found PK E. side P. pole	N 25° E	89.8'
Found PK SW side P. pole	S 40° E	55.77'
Found N&T E. side 40" Oak	S 15° W	94.55'
SE cor hse fndn	N 30° W	98.7'

Accepted as best evidence of corner location.

SURVEY &
REMONUMENTATION

APR 05 1994

COMMISSION

C. Description of monument for corner and accessories established to perpetuate locating the position of the corner:

Replaced with 4"x24" Std. Barry Co. Capped Monument

Found PK E. side P. pole	N 25° E	89.8'
Found PK SW side P. pole	S 40° E	55.77'
Found N & T E. side 40" Oak	S 15° W	94.55'
SE corner house foundation on E-W C/L pavement	N 30° W	98.7'

C/L to South is 2' East &
C/L to North is 4' East



Signed by Robert J. Jonker
JONKER LAND SURVEYS
Surveyor's Michigan License No. 21572

Date November 29, 1993