

APR 04 2000

BARRY COUNTY REMONUMENTATION

SECTION

LAND CORNER RECORDATION CERTIFICATE
Filing Requirement of Act 74, Mich. P.A. 1970

For Corners in BARRY (county) Located In: Corner Code #
1. Public Land Survey T 4N R 10W H-9
1/4 CORNER COMMON TO SECTIONS 22 & 27 THORNAPPLE TOWNSHIP
2. Property Controlling in Section S T R
3. Miscellaneous S T R

Barcode with number 2864 and text: Page: 1 of 1 12/27/1999 01:44P Darla K. Burghdoff - Barry Co. LCRCR

Register of Deeds Stamp & File Number

Grid table with columns A-M and rows 1-13. Cell (10, 27) contains a black dot.

I, Brian Reynolds, in a field survey on 21 DECEMBER, 1999 do hereby certify that under requirements of P.A. 74, Michigan P.A. of 1970, the corner points mentioned in lines 1 and 2 above were in conformance with regulations and rules therefore as required in the current manual of survey instructions of the United States Department of the Interior, Bureau of Land Management or by a decree of a Court of Law and/or that the corner points mentioned in lines 3, 4, and 5 above were in conformance with the rules of the Michigan Board of Land Surveyors or by a Decree of a Court of Law, established, re-established, monumented, re-monumented, recovered, found as expressed below.


NOTE: Not more than 2 corners, all in the same town and range, may be recorded on this certificate.

- A. Description of original monument and accessories and/or subsequent restoration:
1. GENERAL LAND OFFICE: SYLVESTER SIBLEY, D.S., 1830 (R10W, P.170) W. O. 8 S74W 11 Do. 8 N68E 34
2. COUNTY SURVEYOR RECORDS: NO NAME OR DATE (THORNAPPLE F.B., P. 88) "SET STONE 36X6X6 IN PLACE OF STAKE"
3. COUNTY SURVEYOR RECORDS: A. D. RORK, APRIL 30, 1866 (L.2, P.103) "SET POST & TOOK BEARINGS STONE & BRICK IN HOLE" B. OAK 7 N65 3/4E .86 W. OAK 14 S64 3/4W 1.15
4. COUNTY ROAD COMMISSION: NO NAME, 28-JULY-1971, "IRON" NW CORNER HOUSE S20°E 90.7' NW COR HOUSE S20°W 88.7' C/L STADIUM DR. E. 112.1'
5. CONSUMERS POWER COMPANY: NO NAME 8-71 & 11-71 (F.B. P. 863)"FND BOAT SPIKE" P. POLE N75°W 99.09' P. POLE N50°E 35.37' P. POLE S22°E 51.40' CORN. IS 113' W. OF STADIUM DR. IN LINE WITH FNC. NORTH
6. LAND CORNER RECORDATION CERTIFICATE: #47, BY DOUGLAS BONNEMA, P.S. #12579, 4-18-72, "NAIL & WASHER IN CENTERLINE OF ROAD" NW CORNER HOUSE S20°E 90.7' NW CORNER HOUSE S20°W 88.7' C/L STADIUM DRIVE EAST 112.1'
7. ACT 132 SURVEY: BY DONALD A. RATEKIN, P.S. #8781, 12-13-1972 (L.1, P.71) SAME WITNESSES AS IN #6 ABOVE
8. ACT 132 SURVEY: BY FRANCIS E. SPICER, P.S. #7877, 3-19-1976 (L.1, P.321) SAME WITNESSES AS IN #6 ABOVE
9. ACT 132 SURVEY: BY FRANCIS E. SPICER, P.S. #7877, 3-19-1976 (L.1, P.324) SAME WITNESSES AS IN #6 ABOVE
10. ACT 132 SURVEY: BY DOUGLAS BONNEMA, P.S. #12579, 10-22-1976 (L.1, P.338) SAME WITNESSES AS IN #6 ABOVE
11. ACT 132 SURVEY: BY JOHN MERDZINSKI, P.S. #18687, 11-04-1977 (L. 1, P.422-424) "BOAT SPIKE" P&T POLE N60°E 35.38' P POLE S20°E 51.38' P&T POLE N80°W 99.00' P&T POLE S50°E 96.20'
12. 10 RECORDED PLATS: HENRY STEHR'S PLAT, IVAN FRENCH, RPE. 3495 11-8-1955 (L.4, P.5); CHARLESON HEIGHTS ADDITION, W.B. WILLIAMS, P.S. #2375, 12-18-1953 (L. 4, P. 38); CHARLESON HEIGHTS ADDITION #1, E. THOMPSON, RPE#8606, 10-3-1959 (L.4, P.42); CHARLESON HEIGHTS ADDITION #2, E. THOMPSON, RPE#8606, 4-9-1962 (L.4, P.62); MIDDLEVILLE MANOR ADDITION TO THE VILLAGE OF MIDDLEVILLE, E. THOMPSON, RPE#8606, 5-16-1962 (L. 4, P. 64); MIDDLEVILLE DOWNS ADDITION, E. THOMPSON, RPE#8606, 5-16-1962 (L.4, P.65); MIDDLEVILLE DOWNS ADDITION #1, E. THOMPSON, RPE#8606, 12-6-1962 (L.5, P.4); MIDDLEVILLE DOWNS ADDITION #2, E. THOMPSON, RPE#8606, 11-7-1963 (L.5, P.13); MIDDLEVILLE DOWNS ADDITION #3, M.M. CHAMBERS P.S.#7861, 11-30-1964 (L.5, P.26); MIDDLEVILLE DOWNS ADDITION #4, M.M. CHAMBERS P.S.#7861, 12-13-1965 (L.5, P.41) NO MONUMENT OR WITNESSES ARE RECITED ON ANY OF THESE PLATS.

B. Description of corner evidence found and/or method applied in restoring or reestablishing corner:
FOUND 1/2" IRON IN PAVEMENT. ACCEPTED FOUND 1/2" IRON AS BEST AVAILABLE EVIDENCE OF CORNER POSITION. REPLACED FOUND 1/2" IRON WITH STANDARD BARRY COUNTY REMONUMENTATION MONUMENT AND INSTALLED MONUMENT BOX.

C. Description of monument for corner and accessories established to perpetuate locating the position of the corner:
SET STANDARD BARRY COUNTY REMONUMENTATION MONUMENT (3/4" X 36" IRON) WITH ALUMINUM CAP.
SET 20d NAIL W/REMON TAG IN THE SOUTHEAST SIDE OF A UTILITY POLE N54°E 35.23'
SET 20d NAIL W/REMON TAG IN THE SOUTHWEST SIDE OF A UTILITY POLE N77°W 99.05'
SET 20d NAIL W/REMON TAG IN THE SOUTHEAST SIDE OF A UTILITY POLE S65°W 109.48'
SET 20d NAIL W/REMON TAG IN THE EAST SIDE OF A UTILITY POLE S23°E 51.31'
SET 20d NAIL W/REMON TAG IN THE NORTH SIDE OF A UTILITY POLE N81°E 145.57'
CORNER LIES ON EAST-WEST CENTERLINE

ACT 345 BARRY COUNTY REMONUMENTATION
APPROVED BY PEER REVIEW AT A MEETING HELD ON
14 June 99
BRIAN REYNOLDS COUNTY SURVEYOR

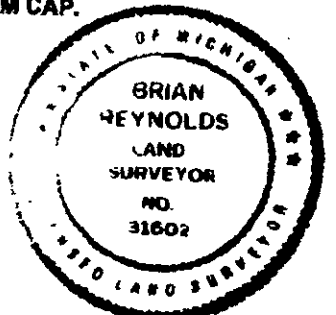

Signed by [Signature]
Surveyor's Michigan License No 31602

Date DEC 27, 1999