

APR 04 2000

BARRY COUNTY REMONUMENTATION LAND CORNER RECORDATION CERTIFICATE Filing Requirement of Act 74, Mich. P.A. 1970

SECTION

For Corners in BARRY (county) Located In: Corner Code # 1. Public Land Survey CORNER COMMON TO SECTIONS 22, 23, 26, & 27 THORNAPPLE TOWNSHIP T 4N R 10W I-9

Barcode 2867 Page: 1 of 1 12/27/1999 01:44P Darla K. Burahdoff- Barry Co. LCRCR

Register of Deeds Stamp & File Number

4. Lot No. Recorded Plat 5. Private Claims

Grid table with columns A-M and rows 1-13. A dot is present in cell G9.

I, Brian Reynolds, in a field survey on 21 DECEMBER, 1999 do hereby certify that under requirements of P.A. 74, Michigan P.A. of 1970, the corner points mentioned in lines 1 and 2 above were in conformance with regulations and rules therefore as required in the current manual of survey instructions of the United States Department of the Interior, Bureau of Land Management or by a decree of a Court of Law and/or that the corner points mentioned in lines 3, 4, and 5 above were in conformance with the rules of the Michigan Board of Land Surveyors or by a Decree of a Court of Law; established, re-established, monumented, re-monumented, recovered, found as expressed below.

NOTE: Not more than 2 corners, all in the same town and range, may be recorded on this certificate.


- A. Description of original monument and accessories and/or subsequent restoration: 1. GENERAL LAND OFFICE: SYLVESTER SIBLEY, D.S., 1830 (R10W, P.164) BEECH 20 S17 1/2 E 28 W. OAK 30 N71W 27 2. COUNTY SURVEYOR RECORDS: LEE S. COBB, 6-17-1893 (THORNAPPLE F.B., P.86-87) "FOUND OLD STAKES SET IRON SHAFT 20" LONG WHEEL ON BOTTOM" SUGAR 24 S25E 63 S.E. CORNER HOME WALL N45°W 94 NE CORNER HOME WALLS25°W 104 1/2 3. COUNTY ROAD COMMISSION: VANDENBURG, MARCH 1954, "3/4" BOLT IN PAVEMENT" 18" ASH S63°W 78.40' 21" MAPLE S23°E 59.45' 30" ELM N6°W 53.75' 4. COUNTY ROAD COMMISSION: RATEKIN (DEKEYSER FILES) 7-26-71, "IRON" SW COR FACTORY N 72.4' SE COR PORCH N40°W 68.1' 26" MAPLE S20°E 58.3' C/L CRACK IN PAVEMENT S. 1.0' 5. LAND CORNER RECORDATION CERTIFICATE: #47, DONALD A. RATEKIN, P.S. #8781, 4-18-72, "1" IRON" SAME WITNESSES AS IN #4 6. ACT 132 SURVEY: BY DONALD A. RATEKIN, P.S. #8781, 12-13-1972 (L.1, P.71) SAME WITNESSES AS IN #4 ABOVE 7. ACT 132 SURVEY: BY DOUGLAS BONNEMA, P.S. #12579, 10-22-1976 (L.1, P.338) SAME WITNESSES AS IN #4 ABOVE 8. ACT 132 SURVEY: BY JOHN A. MERDZINSKI, P.S. #10697, 11-4-1977 (L.1, P.422-424) SAME WITNESSES AS IN #4 ABOVE 9. ACT 132 SURVEY: BY ROBERT J. JONKER, P.S. #21572, 12-8-1982 (L.1, P.732-733) "1" IRON" SAME WITNESSES AS IN #4 ABOVE 10. RECORDED PLATS: JOHNSON'S ADDITION TO THE VILLAGE OF MIDDLEVILLE, 5-14-1889 (L.1, P.2) NO WITNESSES 11. RECORDED PLATS: VILLAGE OF MIDDLEVILLE, A.C. WILSON, 12-06-1869 (L.1, P.27) NO WITNESSES 12. RECORDED PLATS: A.D. BABCOCKS ADDITION TO THE VILLAGE OF MIDDLEVILLE, 01-21-1870 (L.1, P.26) NO WITNESSES 13. RECORDED PLATS: ASSESSOR'S PLAT OF MIDDLEVILLE, R.J. ROBB, 6-27-1937 (L. 3, P.12) NO WITNESSES 14. RECORDED PLATS: THORNTON ADDITION TO THE VILLAGE OF MIDDLEVILLE, IVAN F. FRENCH, 10-26-1951 (L.3, P.72) NO WITNESSES

B. Description of corner evidence found and/or method applied in restoring or reestablishing corner: FOUND 1" AXLE SHAFT, IN CONCRETE ROADWAY (UNDER BITUMINOUS). EXCAVATION TO A DEPTH OF 1'+ REVEALED THAT THE AXLE SHAFT IS SURROUNDED BY CONCRETE. FOUND MOST WITNESSES IN ITEMS 2-9 ABOVE. ACCEPTED FOUND AXLE SHAFT IN CONCRETE AS CORNER POSITION BY COBB. WE WERE UNABLE TO REMOVE AXLE SHAFT WITHOUT EXTENSIVE EXCAVATION AND DAMAGE TO THE ROAD. LEFT AXLE SHAFT IN CONCRETE IN PLACE FOR CORNER AND INSTALLED MONUMENT BOX.

C. Description of monument for corner and accessories established to perpetuate locating the position of the corner: 1" AXLE SHAFT IN CONCRETE WITH MONUMENT BOX SET 20d NAIL W/REMON TAG IN THE SOUTHEAST SIDE OF A 36" MAPLE N30°W 39.89' SET 20d NAIL W/REMON TAG IN THE SOUTHWEST SIDE OF A UTILITY POLE N53°W 41.88' SET 20d NAIL W/REMON TAG IN THE SOUTHWEST SIDE OF A 24" PINE S01°W 36.33' SOUTHWEST CORNER OF FACTORY BUILDING N01°E 72.29' SOUTHEAST FOUNDATION CORNER OF A PORCH N46°W 76.32' CORNER LIES 1± NORTH OF EAST-WEST CENTERLINE

ACT 345 BARRY COUNTY REMONUMENTATION APPROVED BY PEER REVIEW AT A MEETING HELD ON

14 June, 99 B. REYNOLDS COUNTY SURVEYOR

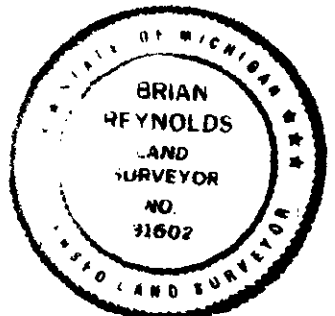

Signed by [Signature] Surveyor's Michigan License No 31602

Date DEC 27, 1999