

RECORDATION

APR 04 2000

SECTION


BARRY COUNTY REMONUMENTATION

LAND CORNER RECORDATION CERTIFICATE
Filing Requirement of Act 74, Mich. P.A. 1970

For Corners in BARRY (county) Located In: Corner Code #

1. Public Land Survey 1/4 CORNER COMMON TO SECTIONS 26 & 27 THORNAPPLE TOWNSHIP

T 4N R 10W I-10

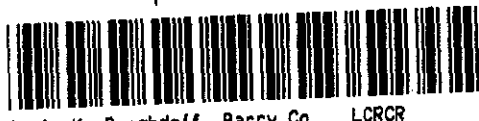

2868 Page: 1 of 1 12/27/1999 01:44P

2. Property Controlling in Section

3. Miscellaneous

4. Lot No. Recorded Plat
5. Private Claims

Register of Deeds Stamp & File Number

Grid table with columns A-M and rows 1-13. Cell 10,27 contains a black dot.

I, Brian Reynolds, in a field survey on 21 DECEMBER, 1999 do hereby certify that under requirements of P.A. 74, Michigan P.A. of 1970, the corner points mentioned in lines 1 and 2 above were in conformance with regulations and rules therefore as required in the current manual of survey instructions of the United States Department of the Interior, Bureau of Land Management or by a decree of a Court of Law and/or that the corner points mentioned in lines 3, 4, and 5 above were in conformance with the rules of the Michigan Board of Land Surveyors or by a Decree of a Court of Law; established, re-established, monumented, re-monumented, recovered, found as expressed below.

NOTE: Not more than 2 corners, all in the same town and range, may be recorded on this certificate.

- A. Description of original monument and accessories and/or subsequent restoration:
1. GENERAL LAND OFFICE: SYLVESTER SIBLEY, D.S., 1830 (R10W, P.164) CHERRY 6 N66E B. ASH 10 S70W 15
2. COUNTY ROAD COMMISSION: RATEKIN / DEKEYSER FILES (11-29-1971) "1/2" IRON PIPE
3. LAND CORNER RECORDATION CERTIFICATE: #448, BY DONALD RATEKIN, P.S. #8781, 4-18-72, "1/2" PIPE ON TOP OF E. BANK OF DITCH AT P.I. NAIL & TAG IN 8" BASSWOOD CLUMP WEST 7.68' NAIL & TAG IN 10" OAK NORTH 20.38' 8" BASSWOOD CLUMP W 7.68' (NAIL) 10" OAK N 20.38'
4. ACT 132 SURVEY: DONALD RATEKIN, P.S. #8781, 12-13-1972 (L. 1, P.75) "1/2" IRON PIPE NAIL & TAG IN 8" BASSWOOD CLUMP WEST 7.68' NAIL & TAG IN 10" OAK NORTH 20.38'
5. RECORDED PLATS: MARKET STREET PLAT, BY DONALD RATEKIN, P.S. #8781, 6-24-1976 (L.5, P.89) NO WITNESSES
6. LAND CORNER RECORDATION CERTIFICATE: #276, BY DOUGLAS BONNEMA, P.S. #12579, 6-28-1979 "1/2" IRON NAIL IN SDE 16" OAK SW 30.82' NAIL IN SDE 6" BASSWOOD CLUMP WNW 8.87' NAIL IN SDE 10" TRIPLE OAK NORTH 20.28'
7. ACT 132 SURVEY: DOUGLAS BONNEMA, P.S. #12579, 7-2-1979 (L.1, P.533) "1/2" IRON NAIL IN SIDE 6" BASSWOOD WNW 8.87' NAIL IN SIDE 10" TRI. OAK N 20.28' FENCE CORNER TO S & W IS .5' S.
8. ACT 132 SURVEY: ROBERT J. JONKER, P.S. #21672, 12-8-1982 (L.1, P.732-733) "1/2" IRON NAIL IN SDE 16" OAK SW 30.82' NAIL IN SDE 6" BASSWOOD CLUMP WNW 8.87' NAIL IN SDE 10" TRIPLE OAK NORTH 20.28' FENCE COR. TO S & W IS .5' SOUTH
9. LAND CORNER RECORDATION CERTIFICATE: #407, JOHN C. BUECHE, P.S. #13207, 3-19-90, "3/4" IRON NAIL IN W. SIDE TWIN 20" OAK N6°W 20.41' NAIL IN N SIDE 6" MAPLE IN CLUMP N60°W 8.95' PK IN W. SIDE Tw. 5" WILD CHERRY S. 14.07' PK IN E. SIDE 8" ELM N20°W 52.92' FENCE COR., FENCE S & W S45°W 4.00'

B. Description of corner evidence found and/or method applied in restoring or reestablishing corner: FOUND 3/4" PIPE AND MOST WITNESSES IN ITEM #S 2-9 ABOVE. TRAVERSED ALL OF SECTION 27, TYING OCCUPATION. FOUND PIPE CONFORMS WITH CORRESPONDING SECTION CORNERS AND LOCAL OCCUPATION. ACCEPTED FOUND 3/4" PIPE AS BEST AVAILABLE EVIDENCE OF CORNER POSITION. SET STANDARD BARRY COUNTY REMONUMENTATION MONUMENT OVER 3/4" PIPE.

C. Description of monument for corner and accessories established to perpetuate locating the position of the corner: SET STANDARD BARRY COUNTY REMONUMENTATION MONUMENT (3/4" X 36" IRON) WITH ALUMINUM CAP. SET 20d NAIL WIREMON TAG IN THE EAST SIDE OF A 10" OAK N10°W 22.40' SET 20d NAIL WIREMON TAG IN THE SOUTH SIDE OF A 10" MAPLE N50°W 59.12' SET 20d NAIL WIREMON TAG IN THE SOUTH SIDE OF A 14" BASSWOOD WEST 7.28' FOUND NAIL IN A BASSWOOD CLUMP N75°W 8.90' FOUND NAIL & TAG IN A 10" ELM SOUTH 21.20' FENCE CORNER WITH FENCES RUNNING SOUTH AND WEST LIES S45°W 0.5'

ACT 345 BARRY COUNTY REMONUMENTATION APPROVED BY PEER REVIEW AT A MEETING HELD ON 14 June '99 BRIAN REYNOLDS COUNTY SURVEYOR



Signed by [Signature] Surveyor's Michigan License No 31602

Date DEC 27, 1999