

APR 04 2000

BARRY COUNTY REMONUMENTATION

SECTION

LAND CORNER RECORDATION CERTIFICATE
Filing Requirement of Act 74, Mich. P.A. 1970

For Corners in BARRY Located In: Corner Code #
(county)

1. Public Land Survey T 4N R 10W I-11
CORNER COMMON TO T _____ R _____
SECTIONS 26, 27, 34 & 35 T _____ R _____
THORNAPPLE TOWNSHIP T _____ R _____

2. Property Controlling S _____ T _____ R _____
in Section S _____ T _____ R _____

3. Miscellaneous S _____ T _____ R _____

4. Lot No _____, Recorded Plat _____

5. Private Claims _____



2869

Page: 1 of 1
12/27/1999 01:44P

Darla K. Burghdoff - Barry Co. LCRCR

Register of Deeds Stamp & File Number

I, Brian Reynolds, in a field survey on 21 DECEMBER, 1999 do hereby certify that under requirements of P.A. 74, Michigan P.A. of 1970, the corner points mentioned in lines 1 and 2 above were in conformance with regulations and rules therefore as required in the current manual of survey instructions of the United States Department of the Interior, Bureau of Land Management or by a decree of a Court of Law and/or that the corner points mentioned in lines 3, 4, and 5 above were in conformance with the rules of the Michigan Board of Land Surveyors or by a Decree of a Court of Law, established, re-established, monumented, re-monumented, recovered, found as expressed below.

NOTE: Not more than 2 corners, all in the same town and range, may be recorded on this certificate.

	A	B	C	D	E	F	G	H	I	J	K	L	M
1													
2	8	5	4	3	2	1							
3													
4	7	8	9	10	11	12							
5													
6	18	17	16	15	14	13							
7													
8	19	20	21	22	23	24							
9													
10	30	29	28	27	26	25							
11													
12	31	32	33	34	35	36							
13													

A. Description of original monument and accessories and/or subsequent restoration:

- GENERAL LAND OFFICE: SYLVESTER SIBLEY, D.S., 1830 (R10W, P.163) W. OAK 10 N88E 52 Do. 16 N54W 54
- LAND CORNER RECORDATION CERTIFICATE: #147, BY DOUGLAS W. BONNEMA, P.S. #12579 (7-25-74) "FOUND 3/4" IRON" NAIL IN SDE 36" MAPLE SW 37.64' NAIL IN SDE 16" OAK NW 39.14' NAIL IN SDE 40" OAK NE 33.18'
- COUNTY ROAD COMMISSION: ADAMS RD. (F.B., P.2), "DRAG TOOTH, FOUND IRON" 30" OAK N45°E 31.5' 30" OAK N20°W 27.2' 30" MAPLE S45°W 36.55'
- HIGHWAY DEPARTMENT: 1963 HIGHWAY PLANS, PAGE 5, CORNER IS SHOWN BUT NO WITNESSES GIVEN
- ACT 132 SURVEY: BY DOUGLAS BONNEMA, P.S. #12579, (L.1,P.244) 8-2-1974, RECITE SAME WITNESSES AS IN #2 ABOVE
- ACT 132 SURVEY: BY DOUGLAS BONNEMA, P.S. #12579, (L.1,P.528) 7-2-1979, RECITE SAME WITNESSES AS IN #2 ABOVE
- ACT 132 SURVEY: BY DOUGLAS BONNEMA, P.S. #12579, (L.1,P.820) 9-5-1985, "CAPPED SPIKE IN MON BOX" PK NE SDE 30" OAK N15°W 28.36' NAIL & TAG SE SDE 40" OAK N55°E 33.18' SPIKE NW SDE 36" MAPLE S55°W 37.80'
- ACT 132 SURVEY: BY ROBERT J. JONKER, P.S. #21572, (L.1,P.877-891) 3-21-1988, "3/4" IRON IN MON. BOX" N&BC IN NW SIDE 36" MAPLE S55°W 37.54' N&BC IN SW SIDE 16" OAK N45°W 39.14' N&BC IN SE SIDE 40" OAK N55°E 33.18'
- ACT 132 SURVEY: BY DOUGLAS BONNEMA, P.S. #12579, (L.1,P.915) 11-18-1988, RECITE SAME WITNESSES AS IN #7 ABOVE

B. Description of corner evidence found and/or method applied in restoring or reestablishing corner:


FOUND BOAT SPIKE IN MONUMENT BOX AND ALL WITNESSES AS RECITED IN ITEMS #2-9 ABOVE (NAILS ALL OVERGROWN). TRAVERSED ALL OF SECTION 27, TYING IN OCCUPATION THROUGHOUT SECTION. FOUND BOAT SPIKE IN MONUMENT BOX CONFORMS WITH MEASURED DISTANCES TO ADJACENT SECTION CORNERS AND LOCAL OCCUPATION. EXCAVATION BELOW SPIKE REVEALED NO FURTHER EVIDENCE OF CORNER MONUMENTATION. ACCEPTED FOUND BOAT SPIKE IN MONUMENT BOX AS BEST AVAILABLE EVIDENCE OF CORNER POSITION. REPLACED BOAT SPIKE IN MONUMENT BOX WITH STANDARD BARRY COUNTY REMONUMENTATION MONUMENT.

C. Description of monument for corner and accessories established to perpetuate locating the position of the corner:

SET STANDARD BARRY COUNTY REMONUMENTATION MONUMENT (3/4" X 36" IRON) WITH ALUMINUM CAP.
SET 20d NAIL W/REMON TAG IN THE NORTHWEST SIDE OF A 36" OAK S47°W 37.56'
SET 20d NAIL W/REMON TAG IN THE WEST SIDE OF A 36" OAK N28°W 28.09'
SET 20d NAIL W/REMON TAG IN THE SOUTHEAST SIDE OF A 36" OAK N51°W 32.81'
SET 20d NAIL W/REMON TAG IN THE NORTHEAST SIDE OF A UTILITY POLE S86°E 168.36'
CORNER LIES ON EAST-WEST CENTERLINE
CORNER LIES ON CENTERLINE TO THE SOUTH

ACT 345 BARRY COUNTY REMONUMENTATION
APPROVED BY PEER REVIEW AT A MEETING HELD ON

14 June, 99
BRIAN REYNOLDS COUNTY SURVEYOR

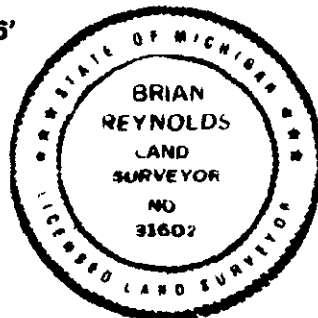

Signed by [Signature]
Surveyor's Michigan License No. 31602

Date DEC 27, 1999