

APR 08 1996

BARRY COUNTY REMONUMENTATION

STATE OF MICHIGAN
COUNTY OF BARRY
RECEIVED FOR RECORD

DEC 15 2 07 PM '95

COMMISSION

LAND CORNER RECORDATION CERTIFICATE

Filing Requirement of Act 74, Mich. P.A. 1970

Sandy Schondelmaier
REGISTER OF DEEDS

002343

Register of Deeds Stamp & File Number

For corners in

BARRY

(County)

Located In:

Corner Code #

1. Public Land Survey	T	<u>4N</u>	R	<u>10W</u>	<u>J-3</u>
1/4 CORNER COMMON TO SECTIONS 2 & 11 THORNAPPLE TOWNSHIP	T		R		
	T		R		
	T		R		
2. Property Controlling in Section	S		T		R
	S		T		R
3. Miscellaneous Property in Sec.	S		T		R
	S		T		R

4. Lot No. _____, Recorded Plat _____
 5. Private Claims _____

BRIAN REYNOLDS

6 SEPT

95

I, BRIAN REYNOLDS, in a field survey on 6 SEPT, 1995, do hereby certify that under requirements of P.A. 74, Michigan P.A. of 1970, the corner points mentioned in lines 1 and 2 above were in conformance with regulations and rules therefore as required in the current manual of survey instructions of the United States Department of the Interior, Bureau of Land Management or by a decree of a Court of Law and/or that the corner points mentioned in lines 3, 4 and 5 above were in conformance with the rules of the Michigan Board of Land Surveyors or by a Decree of a Court of Law; established, re-established, monumented, re-monumented, recovered, found as expressed below:

NOTE: Not more than 4 corners, all in the same town and range, may be recorded on this certificate.

A	B	C	D	E	F	G	H	I	J	K	L	M
2	6	5	4	3	2	1						
3									●			
4	7	8	9	10	11	12						
5												
6	18	17	16	15	14	13						
7												
8	19	20	21	22	23	24						
9												
10	30	29	28	27	26	25						
11												
12	31	32	33	34	35	36						
13												

A. Description of original monument and accessories and/or subsequent restoration:

GENERAL LAND OFFICE: SYLVESTER SIBLEY, D.S., 1830 (R10W,P.168) WEST CORRECTED 40.01 ASPIN 8 S16W 29 W.OAK 8 N53E 55
 COUNTY SURVEYOR RECORDS: CRESSEY, MARCH, 1874 (THORN, F.B.,P.88) A W.OAK 24 S3 1/2E 1.14 Do. 24 S80 1/2W 68 1/2
 LAND CORNER RECORDATION CERTIFICATE: #120 BY D. BONNEMA, P.S.#12579, "FOUND T" IRON. CHECKS WITH PREVIOUS WITNESSES"
 PK IN SIDE GUY POLE ESE 47.84' NAIL IN SDE 12" MAPLE SW 117.86' NAIL IN SDE 24" OAK NORTH 39.15' C/L B.T. NORTH 9'
 LAND CORNER RECORDATION CERTIFICATE: #375 BY P.E. VAN KOOTEN, P.S.#8618, "FOUND T" IRON 1' DEEP FROM PREVIOUS WITNESSES; SET 1/2" CAPPED IRON ON TOP" Sq. SPIKE IN E SIDE 36" HACKBERRY N 39.04' Sq SPIKE IN NW SIDE 18" BASSWOOD SW 107.78'
 Sq SPIKE IN NLY SIDE APPLE CLUMP W-NW 107.11'
 COUNTY ROAD COMMISSION: RECITE SAME WITNESSES AS BONNEMA IN L.C.R.C.#120 ABOVE.
 ACT 132 SURVEYS: BY D. BONNEMA, P.S.#12579, L.1,P.487 L.1,P.242 L.1,P.266 L.1,P.343-344 L.1,P.477 L.1,P.534 L.1,P.827-828 L.2,P.6-7 L.2,P.52 L.2,P.59 ALL SURVEYS RECITE SAME WITNESSES AS IN L.C.R.C.#120 ABOVE
 ACT 132 SURVEY: BY C.S. HAY, P.S.#10688 L.1,P.870 "CAPPED IRON OVER T" IRON" C/L WHITNEYVILLE AVE WEST 84'+/- C/L PARMALEE NORTH 8'+/-
 SEE REVERSE OF THIS FORM FOR ADDITIONAL HISTORICAL INFORMATION

B. Description of corner evidence found and/or method applied in restoring or reestablishing corner:


**FOUND 1/2" IRON FROM BONNEMA'S WITNESSES (OAK NORTH & C/L NORTH)
 CORNER LIES IN A 6'- 8' FILL AREA. ANY EVIDENCE OF ORIGINAL CORNER HAS MOST LIKELY BEEN DESTROYED.
 BASED ON MEASUREMENTS AROUND ALL OF SECTIONS 10 & 11, ACCEPTED FOUND 1/2" IRON AS BEST EVIDENCE OF CORNER POSITION.
 REPLACED FOUND 1/2" IRON WITH STANDARD BARRY COUNTY REMONUMENTATION MONUMENT.**

ACT 345 BARRY COUNTY REMONUMENTATION
 APPROVED BY PEER REVIEW AT A MEETING HELD ON

9/11/95 BR
 BRIAN REYNOLDS COUNTY SURVEYOR

C. Description of monument for corner and accessories established to perpetuate locating the position of the corner:

SET STANDARD BARRY COUNTY REMONUMENTATION MONUMENT (WITH PLASTIC CAP)
 SET 20d NAIL W/REMON TAG IN THE WEST SIDE OF A 30" BLACK WALNUT N8°W 38.87'
 SET 20d NAIL W/REMON TAG IN THE NORTHWEST SIDE OF AN 18" OAK S55°W 117.75'
 SET 20d NAIL W/REMON TAG IN THE NORTHWEST SIDE OF AN 8" ELM S32°W 25.60'
 A COAST AND GEODETIC SURVEY BENCH MARK DESIGNATION K167 N28°W 127.86'
 CENTERLINE OF AN EAST-WEST BITUMINOUS ROAD (PARMALEE) NORTH 8'+/-
 CENTERLINE WHITNEYVILLE ROAD IS WEST 55'+/-

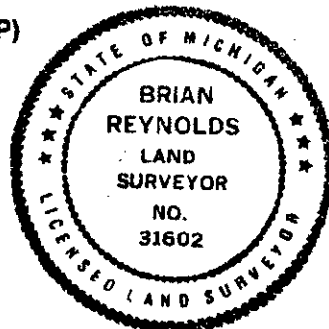

Signed by Brian Reynolds

Date 12/15/95

Surveyor's Michigan License No. 31602

ACT 132 SURVEY: BY ROBERT J. JONKER, P.S. 21572, L.1,P.983-985 WITNESSES SAME AS IN L.C.R.C.#120 ABOVE

ACT 132 SURVEY: BY R.D. UNEMA, P.S. 33987, L.2,P.11-12 "1/2" RE-ROD"
SPK IN E SDE 28" HACKBERRY N05°W 38.97' C/L "X" B.T. WEST 54.8' C/L B.T. NORTH 7.3'
NAIL IN SW SDE 8" CH. ELM SE 47.40'

ACT 132 SURVEY: BY D.L. HERREMA, P.S.# 24597 WITNESSES SAME AS UNEMA (L.2,P.11-12)
ALSO NAIL IN E SDE 8" CH. ELM S-SW 25.24'