

APR 08 1996

BARRY COUNTY REMONUMENTATION

STATE OF MICHIGAN  
COUNTY OF BARRY  
RECEIVED FOR RECORD

COMMISSION LAND CORNER RECORDATION CERTIFICATE  
Filing Requirement of Act 74, Mich. P.A. 1970

DEC 15 2 07 PM '95

Sandy Schondelmar  
REGISTER OF DEEDS

002348

For corners in

BARRY  
(County)

Located In:

Corner Code #/

1. Public Land Survey	T	<u>4N</u>	<u>R10W</u>	<u>J-5</u>
1/4 CORNER COMMON TO	T	_____	R _____	_____
SECTIONS 11 & 14	T	_____	R _____	_____
THORNAPPLE TOWNSHIP	T	_____	R _____	_____
2. Property Controlling	S	_____	T _____	R _____
in Section	S	_____	T _____	R _____
3. Miscellaneous	S	_____	T _____	R _____
Property in Sec.	S	_____	T _____	R _____

Register of Deeds Stamp & File Number

4. Lot No. \_\_\_\_\_, Recorded Plat \_\_\_\_\_  
 5. Private Claims \_\_\_\_\_

A	B	C	D	E	F	G	H	I	J	K	L	M
2	6	5	4	3	2	1						
3												
4	7	8	9	10	11	12						
5												
6	16	17	16	15	14	13						
7												
8	19	20	21	22	23	24						
9												
10	30	29	28	27	26	25						
11												
12	31	32	33	34	35	36						
13												

I, BRIAN REYNOLDS, in a field survey on 6 SEPT., 1995, do hereby certify that under requirements of P.A. 74, Michigan P.A. of 1970, the corner points mentioned in lines 1 and 2 above were in conformance with regulations and rules therefore as required in the current manual of survey instructions of the United States Department of the Interior, Bureau of Land Management or by a decree of a Court of Law and/or that the corner points mentioned in lines 3, 4 and 5 above were in conformance with the rules of the Michigan Board of Land Surveyors or by a Decree of a Court of Law; established, re-established, monumented, re-monumented, recovered, found as expressed below:

NOTE: Not more than 4 corners, all in the same town and range, may be recorded on this certificate.

A. Description of original monument and accessories and/or subsequent restoration:

GENERAL LAND OFFICE: SYLVESTER SIBLEY, D.S., 1830 (R10W,P.167) WEST CORRECTED 39.98  
 A. W. OAK 6 S8W 118 A. B. OAK 7 N38 1/2E 117  
 LAND CORNER RECORDATION CERTIFICATE: #120 BY D. BONNEMA, P.S.#12579 "FOUND 3/4" IRON.  
 CHECKS WITH PREVIOUS WITNESSES" NAIL IN SDE 30" OAK SW 38.37  
 NAIL IN SDE 28" OAK NE59.95' PK IN SDE SERV. POLE NORTH 41.18'  
 COUNTY ROAD COMMISSION: WITNESSES SAME AS IN L.C.R.C.#120 ABOVE  
 ACT 132 SURVEYS: BY D. BONNEMA, P.S.#12579, L.1,P.322 L.1,P.418 WITNESSES SAME AS L.C.R.C.#120 ABOVE  
 ACT 132 SURVEY: BY Wm. R. BYL, P.S.#23502 L.1,P.656-657 WITNESSES SAME AS IN L.C.R.C.#120 ABOVE


B. Description of corner evidence found and/or method applied in restoring or reestablishing corner:

FOUND 3/4" IRON PIPE FROM BONNEMA'S WITNESSES (OAK SW & OAK NE).  
 SEARCHED FOR OTHER MONUMENTATION, FOUND NOTHING.  
 BASED ON MEASUREMENTS AROUND SECTIONS 10 & 11,  
 ACCEPTED FOUND PIPE AS BEST EVIDENCE OF CORNER POSITION.  
 REPLACED PIPE WITH STANDARD BARRY COUNTY REMONUMENTATION MONUMENT.

ACT 345 BARRY COUNTY REMONUMENTATION  
 APPROVED BY PEER REVIEW AT A MEETING HELD ON  
9/11/95 BR  
 BRIAN REYNOLDS COUNTY SURVEYOR

C. Description of monument for corner and accessories established to perpetuate locating the position of the corner:

SET STANDARD BARRY COUNTY REMONUMENTATION MONUMENT (3/4"X36"W/ALUMINUM CAP)  
 FOUND NAIL IN THE SOUTHEAST SIDE OF A 36" OAK S49°W 38.31'  
 FOUND NAIL IN THE NORTH SIDE OF A 36" OAK S62°E 64.80'  
 FOUND NAIL IN THE WEST SIDE OF A UTILITY POLE S11°E 61.27'  
 FOUND NAIL IN THE NORTH SIDE OF A 40" OAK N46°E 59.85'  
 CENTERLINE OF EAST-WEST BITUMINOUS ROAD (GARROW) IS NORTH 1+/-

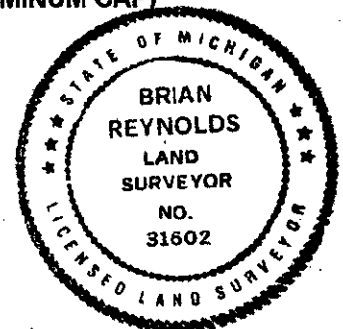

Signed by [Signature]

Date 12/15/95

Surveyor's Michigan License No. 31602