

MAY 20 1997

BARRY COUNTY REMONUMENTATION
LAND CORNER RECORDATION CERTIFICATE
Filing Requirement of Act 74, Mich. P.A. 1970

STATE OF MICHIGAN
COUNTY OF BARRY
REC'D

DEC 10 11 57 AM '96

Sandy B. ...
REGISTER OF DEEDS

For corners in

Barry County (County) Located in: Thornapple Twp. Corner Code #

1. Public Land Survey	T <u>4N</u> R <u>10W</u>	K-1
	T ___ R ___	NW of Sec. 1
	T ___ R ___	
	T ___ R ___	
2. Property Controlling in Section	S ___ T ___ R ___	
	S ___ T ___ R ___	
3. Miscellaneous Property in Sec.	S ___ T ___ R ___	
	S ___ T ___ R ___	
4. Lot No. _____, Recorded Plat _____		
5. Private Claims _____		

002454

Register of Deeds Stamp & File Number

I, Robert Jonker, in a field survey on November 29, 19 96 do hereby certify that under requirements of P.A. 74, Michigan P.A. of 1970, the corner points mentioned in lines 1 and 2 above were in conformance with regulations and rules therefore as required in the current manual of survey instructions of the United States Department of the Interior, Bureau of Land Management or by a decree of a Court of Law and/or that the corner points mentioned in lines 3, 4 and 5 above were in conformance with the rules of the Michigan Board of Land Surveyors or by a Decree of a Court of Law, established, re-established, monumented, re-monumented, recovered, found as expressed below:

A	B	C	D	E	F	G	H	I	J	K	L	M
2	6	5	4	3	2	1						
3												
4	7	8	9	10	11	12						
5												
6	18	17	16	15	14	13						
7												
8	19	20	21	22	23	24						
9												
10	30	29	28	27	26	25						
11												
12	31	32	33	34	35	36						
13												

NOTE: Not more than 4 corners, all in the same town and range, may be recorded on this certificate.

A. Description of original monument and accessories and/or subsequent restoration:

GLO jog of 44 lks. (East of standard corner).
LCRC #145 - Exxel Eng., 1974, found 3/4" Iron

Checks O.K. per gov. distance - took witnesses

Nail - side 20" Oak	SSW 63.33'	Checks O.K. 1996
Nail - side 38" Oak	ENE 99.53'	Checks O.K. 1996
PK - side cor. fce. post NW	40.48'	Checks O.K. 1996
SW corn. Sec.36, T5N, R10W	29.05	Checks O.K. 1996

B. Description of corner evidence found and/or method applied in restoring or reestablishing corner:


In Spring 1996 took witnesses prior to road construction and on Nov. 29, 1996 reset corner from construction witnesses and set on township line, a standard Barry County capped monument.

Accepted as the best available evidence of the position of the corner.

ACT 345 BARRY COUNTY REMONUMENTATION
APPROVED BY PEER REVIEW AT A MEETING HELD ON
12-6-94 BR
BRIAN REYNOLDS COUNTY SURVEYOR

C. Description of monument for corner and accessories established to perpetuate locating the position of the corner:

Barry Co. Monument	N22°E 104.24'
PK nail in BT drive	West 29.05'
Kent Co. Mon.	S75°E 166.0'
PK nail S side P.Pole	S40°W 64.55'
Kent Co. remon tag W side 40" Oak	N65°W 62.0'
C/L gas pipeline marker	

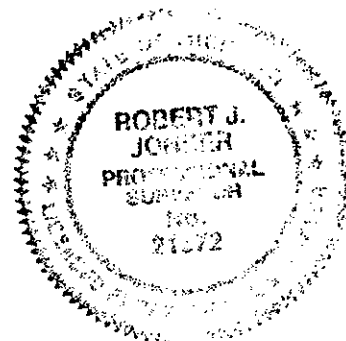

Signed by Robert J. Jonker
Surveyor's Michigan License No. 21572

Date November 29, 1996