

MAY 20 1987

BARRY COUNTY REMONUMENTATION
LAND CORNER RECORDATION CERTIFICATE
Filing Requirement of Act 74, Mich. P.A. 1970

STATE OF MICHIGAN
COUNTY OF BARRY
REC'D

DEC 10 11 57 AM '96

Sandy S. ...
REGISTER OF DEEDS

For corners in

Barry County (County) Located In: Thornapple Twp. Corner Code 11

1. Public Land Survey T 4N R 10W L-1
T ___ R ___ N 1/4 cor Sec. 1
T ___ R ___
T ___ R ___

2. Property Controlling S ___ T ___ R ___
in Section S ___ T ___ R ___

3. Miscellaneous S ___ T ___ R ___
Property in Sec. S ___ T ___ R ___

4. Lot No. _____, Recorded Plat _____

5. Private Claims _____

002453

Register of Deeds Stamp & File Number

I, Robert Jonker, in a field survey on November 29, 1996 do hereby certify that under requirements of P.A. 74, Michigan P.A. of 1970, the corner points mentioned in lines 1 and 2 above were in conformance with regulations and rules therefore as required in the current manual of survey instructions of the United States Department of the Interior, Bureau of Land Management or by a decree of a Court of Law and/or that the corner points mentioned in lines 3, 4 and 5 above were in conformance with the rules of the Michigan Board of Land Surveyors or by a Decree of a Court of Law; established, re-established, monumented, re-monumented, recovered, found as expressed below:

A	B	C	D	E	F	G	H	I	J	K	L	M
2	6	5	4	3	2	1						
3												
4	7	8	9	10	11	12						
5												
6	18	17	16	15	14	13						
7												
8	19	20	21	22	23	24						
9												
10	30	29	28	27	26	25						
11												
12	31	32	33	34	35	36						
13												

NOTE: Not more than 4 corners, all in the same town and range, may be recorded on this certificate.

A. Description of original monument and accessories and/or subsequent restoration:
Not set in GLO survey

LCRC #145, Exxel Eng., 1974, Found 3/4" iron


Nail - side 14" Walnut SW 41.49' OUT 1996
 Nail - side 36" Oak NE 30.32' OUT 1996
 S 1/4 cor. Sec. 36, T5N, R10W W 18.41' IN Checks O.K.
 Nail - side 12" W.Cherry WNW 71.96' IN Checks O.K.

B. Description of corner evidence found and/or method applied in restoring or reestablishing corner:
In Spring 1996 took witnesses prior to road construction and on Nov. 29, 1996 reset corner by the construction witnesses and set standard Barry County capped monument.

Accepted as the best available evidence of the position of the corner.
 ACT 345 BARRY COUNTY REMONUMENTATION
 APPROVED BY PEER REVIEW AT A MEETING HELD ON
12-6-94 BR
 BRIAN REYNOLDS COUNTY SURVEYOR

C. Description of monument for corner and accessories established to perpetuate locating the position of the corner:

Barry County Monument
 K.C. remon tag on SW side 17" Walnut N65°W 71.23'
 K.C. remon tag on E side 14" Walnut N20°W 43.42'
 K.C. remon tag on NW side P.Pole S45°W 85.20'
 Exxel iron South 33'
 Kent County corner West 29.05'

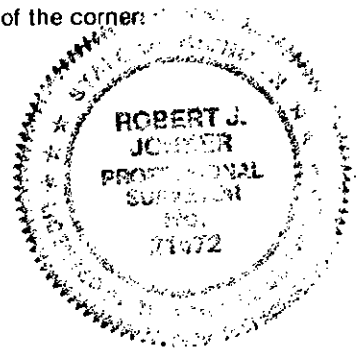

Signed by Robert J. Jonker Date November 29, 1996
 Surveyor's Michigan License No. 21572