

RECORDED

AUG 22 1995

BARRY COUNTY REMONUMENTATION

STATE OF MICHIGAN
COUNTY OF BARRY
RECEIVED FOR RECORD

JAN 25 8 35 AM '95

For corners in
BARRY
(County)

LAND CORNER RECORDATION CERTIFICATE Filing Requirement of Act 74, Mich. P.A. 1970

Sandy Schindelmayer
REGISTER OF DEEDS

Located in: _____ Corner Code # _____

1. Public Land Survey
TOWNSHIP CORNER COMMON
TO THORNAPPLE, IRVING,
YANKEE SPRINGS AND RUTLAND
TOWNSHIPS.

T 3N R 9W
T 3N R 10W
T 4N R 9W
T 4N R 10W
T _____ R _____
T _____ R _____

A-1
M-1
A-13
M-13

002276

2. Property Controlling S _____ T _____ R _____
in Section S _____ T _____ R _____
3. Miscellaneous S _____ T _____ R _____
Property in Sec. S _____ T _____ R _____

Register of Deeds Stamp & File Number

4. Lot No. _____, Recorded Plat _____
5. Private Claims _____

	T3N R9W					T3N R						
	A	B	C	D	E	F	G	H	I	J	K	L
2	6	5	4	3	2							
3												
4	7	8	9	10	11	12						
5												
6	18	17	16	15	14	13						
7												
8	19	20	21	22	23	24						
9												
10	30	29	28	27	26	25						
11												
12	31	32	33	34	35	36						
13												

I, **BRIAN REYNOLDS**, in a field survey on 20 OCTOBER, 19 1994, do hereby certify that under requirements of P.A. 74, Michigan P.A. of 1970, the corner points mentioned in lines 1 and 2 above were in conformance with regulations and rules therefore as required in the current manual of survey instructions of the United States Department of the Interior, Bureau of Land Management or by a decree of a Court of Law and/or that the corner points mentioned in lines 3, 4 and 5 above were in conformance with the rules of the Michigan Board of Land Surveyors or by a Decree of a Court of Law, established, re-established, monumented, re-monumented, recovered, found as expressed below:


NOTE: Not more than 4 corners, all in the same town and range, may be recorded on this certificate.

A. Description of original monument and accessories and/or subsequent restoration:
1 **GENERAL LAND OFFICE: L. LYON, D.S., 1826, A. W. OAK 30 S18E 2.12 Do. 28 N70W 1.32**

SEE REVERSE SIDE FOR MORE HISTORICAL DATA

B. Description of corner evidence found and/or method applied in restoring or reestablishing corner:
FOUND STONE AND WITNESSES BY BONNEMA AND REFERENCED BY BILOW. ACCEPTED STONE AS PERPETUATION OF CORNER BY BATEMAN. REMOVED STONE, REPLACED WITH STANDARD BARRY COUNTY MONUMENT AND CAP.

ACT 345 BARRY COUNTY REMONUMENTATION
APPROVED BY PEER REVIEW AT A MEETING HELD ON
1 NOV. 1994
BRIAN REYNOLDS COUNTY SURVEYOR

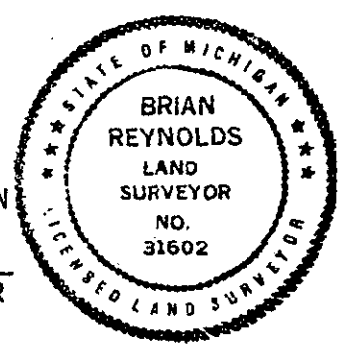

C. Description of monument for corner and accessories established to perpetuate locating the position of the corner:
**SET STANDARD BARRY COUNTY REMONUMENTATION MONUMENT (3/4"X36"W/ALUMINUM CAP)
SET 40d NAIL W/REMON TAG IN THE EAST SIDE OF A POWER POLE NORTH 89.28'
SET 40d NAIL W/REMON TAG IN THE EAST SIDE OF A POWER POLE SOUTH 311.41'
SET 40d NAIL W/REMON TAG IN THE NORTH SIDE WEST TRUNK OF A 20" TWIN OAK EAST 59.94'
SET 40d NAIL W/REMON TAG IN THE NORTH SIDE OF A 15" OAK N75°E 35.99'
SET 40d NAIL W/REMON TAG IN THE NORTH SIDE OF A 12" OAK N45°E 48.71'**

Signed by [Signature]
Surveyor's Michigan License No. 31602

Date JANUARY 24, 1995

072214

PART "A" (CONTINUED)

2. COUNTY SURVEYOR R. J. MERSHON (NO DATE, c. 1870) STAKE AND BRICK, NO WITNESSES, L. 2, P. 218, COUNTY SURVEYORS RECORD.
3. COUNTY SURVEYOR A. N. BATEMAN, SEPTEMBER 1902, L.3, P. 76-77, STAKE AND STONE
4. LCRC #49 BY DOUG BONNEMA PS#12579, NOV. 15, 1972, "FOUND 'X' ON STONE. CHECKS WITH PREVIOUS WITNESSES NAIL IN SIDE 10" OAK E 60.15 NAIL IN SIDE P. POLE N 89.21"
5. ACT 132 SURVEYS BY BONNEMA, L. 1, P. 78; L. 1, P. 186; L. 1, P. 388; L. 1, P. 598; L. 2, P. 50-51, ALL WITH SAME WITNESSES AND MONUMENT AS LCRC #49.
6. ACT 132 SURVEY BY GARY BILOW, PS #26453, L. 1, 728-729, REFERS TO STONE, LCRC #49 WITH NO ADDITIONAL WITNESSES.
7. ACT 132 SURVEY BY EDWARD GLAZA, PS #9548, L. 1, P. 614, SHOWS CORNER, BUT NO MONUMENT OR WITNESSES RECITED.