

APPROVED LAND CORNER  
 P.A. 345 OF 1990 - Bay County  
 Date 18 Oct 96  
MJM  
 Michael MacDonald P.S.  
 County Representative

Bay County Remonumentation

LAND CORNER RECORDATION CERTIFICATE  
 Filing Requirement of Act 74, Mich. P.A. 1970

SURVEY &  
 REMONUMENTATION  
 MAY 20 1997  
 COMMISSION

For corners in

Bay (County)	Located in:	Corner Code #
1. Public Land Survey	T <u>13N</u> R <u>4E</u>	<u>A-5</u>
	T <u>    </u> R <u>    </u>	<u>    </u>
	T <u>    </u> R <u>    </u>	<u>    </u>
	T <u>    </u> R <u>    </u>	<u>    </u>
2. Property Controlling in Section	S <u>    </u> T <u>    </u> R <u>    </u>	<u>    </u>
	S <u>    </u> T <u>    </u> R <u>    </u>	<u>    </u>
3. Miscellaneous Property in Sec.	S <u>    </u> T <u>    </u> R <u>    </u>	<u>    </u>
	S <u>    </u> T <u>    </u> R <u>    </u>	<u>    </u>

REGISTER OF DEEDS  
 BAY COUNTY MICHIGAN  
 Dec 30 4 40 PM '96  
 RECORDED

Register of Deeds Stamp & File Number

4. Lot No. \_\_\_\_\_, Recorded Plat \_\_\_\_\_  
 5. Private Claims \_\_\_\_\_

	A	B	C	D	E	F	G	H	I	J	K	L	M
1													
2		6		5		4		3		2		1	
3													
4		7		8		9		10		11		12	
5													
6		18		17		16		15		14		13	
7													
8		19		20		21		22		23		24	
9													
10		30		29		28		27		26		25	
11													
12		31		32		33		34		35		36	
13													

I, Paul M. Ciosek, in a field survey on October 21, 19 96 do hereby state that under requirements of P.A. 74, Michigan P.A. of 1970, the corner points mentioned in lines 1 and 2 above were in conformance with regulations and rules therefore as required in the current manual of survey instructions of the United States Department of the Interior, Bureau of Land Management or by a decree of a Court of Law and/or that the corner points mentioned in lines 3, 4 and 5 above were in conformance with the rules of the Michigan Board of Land Surveyors or by a Decree of a Court of Law; established, re-established, monumented, recovered, found as expressed below:

NOTE: Not more than 2 corners, all in the same town and range, may be recorded on this certificate.

A. Description of original monument and accessories and/or subsequent restoration:


A-5 Int R.L. 54 N of post - J. Wampler in 1822.  
 Set 3/4" iron 46" N of SE cor of Sec 12, Tittabawassee Twp. - Spicer Engineering in Sept 1973.  
 Fnd 3/4" pipe - Saginaw Co Road Commission Witness - Aug 1975.  
 3/4" pipe - L.C.R.C. - Feb 1976 - L. 2, P. 355.  
 No call - Recorded Surveys - L. 1033, P. 2; L. 1058, P. 5.

B. Description of corner evidence found and/or method applied in restoring or reestablishing corner:

A-5 Fnd 3/4" pipe per Spicer Engineering notes, Saginaw Co Road Commission Witness Card and L.C.R.C. - L. 2, P. 355. In physical centerline of Amelith Road to E.  
 Accepted 3/4" pipe as best available evidence of the position of the original corner.

C. Description of monument for corner and accessories established to perpetuate locating the position of the corner:

A-5 Set Bay County Remon mon (5/8" x 24" rebar with brass cap marked with 3/16" drill hole) in mon box.  
 S 46' to Saginaw Co Remon mon (M-5, T13N, R3E) in mon box.  
 S 30° W 87.75' to nail and tag in NE root of 36" Oak.  
 SW 103.80' to nail and tag in NW face of utility pole.  
 S 75° W 44.35' to nail and tag in N face of P.P.  
 N 75° E 101.57' to nail and tag in S face of U.P.

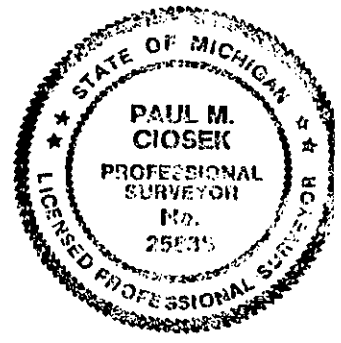

Signed by Paul M. Ciosek  
 Surveyor's Michigan License No. 25835

Date 12/23/96

NOTE: Bearings are estimated and dist are handchained  
 NOTE: See Bay County Remon Field Book Pg. 1 & 59