

MAY 20 1997

COMMISSION

APPROVED LAND CORNER
P.A. 345 OF 1990 - Bay County
Date 7 Nov 96
M.J.N.
Michael MacDonald P.S.
County Representative

Bay County Remonumentation

LAND CORNER RECORDATION CERTIFICATE
Filing Requirement of Act 74, Mich. P.A. 1970

For corners in

Bay (County)	Located In:	Corner Code #
1. Public Land Survey	T <u>13NR</u> <u>4E</u>	<u>A-6</u>
	T <u> </u> R <u> </u>	<u> </u>
	T <u> </u> R <u> </u>	<u> </u>
	T <u> </u> R <u> </u>	<u> </u>
2. Property Controlling in Section	S <u> </u> T <u> </u> R <u> </u>	<u> </u>
	S <u> </u> T <u> </u> R <u> </u>	<u> </u>
3. Miscellaneous Property in Sec.	S <u> </u> T <u> </u> R <u> </u>	<u> </u>
	S <u> </u> T <u> </u> R <u> </u>	<u> </u>

REGISTER OF DEEDS
 BAY COUNTY, MICHIGAN
 Dec 30 4 40 PM '96
 RECORDED
 Register of Deeds Stamp & File Number

4. Lot No. _____, Recorded Plat _____
5. Private Claims _____

I, Paul M. Ciosek, in a field survey on November 5 1996 do hereby state that under requirements of P.A. 74, Michigan P.A. of 1970, the corner points mentioned in lines 1 and 2 above were in conformance with regulations and rules therefore as required in the current manual of survey instructions of the United States Department of the Interior, Bureau of Land Management or by a decree of a Court of Law and/or that the corner points mentioned in lines 3, 4 and 5 above were in conformance with the rules of the Michigan Board of Land Surveyors or by a Decree of a Court of Law; established, re-established, monumented, recovered, found as expressed below:

NOTE: Not more than 2 corners, all in the same town and range, may be recorded on this certificate.

	A	B	C	D	E	F	G	H	I	J	K	L	M
1													
2		6		5		4		3		2		1	
3													
4		7		8		9		10		11		12	
5													
6		18		17		16		15		14		13	
7													
8		19		20		21		22		23		24	
9													
10		30		29		28		27		26		25	
11													
12		31		32		33		34		35		36	
13													

A. Description of original monument and accessories and/or subsequent restoration:

A-6 Not set during original survey.
Recorded Survey - L. 1666, P. 181 - shows A-6, T13N, R4E to be at 31.93' N of M-6, T13N, R3E.
Spicer Engineering Notes - April 1968 - set 3/4" Iron on fence line to E.
Spicer Engineering Notes - June 1979 - show A-6 at 32± N of M-6, T13N, R3E.

B. Description of corner evidence found and/or method applied in restoring or reestablishing corner:


A-6 Fnd 4" dia hole in bit at 31.9' N of M-6, T13N, R3E opposite fence line to E. No reaction with locator. Dug hole 18" in dia through 2" of bit and 6" of gravel and then 2" shale layer into sand, at 2' fnd 6" black sand layer then yellow sand until 3'8" hit clay and at 4'2" quit digging no other evidence found. Accepted position at 31.93' N of M-6, T13N, R3E, per recorded survey L. 1666, P. 181, as best available evidence of the position of the original corner.

C. Description of monument for corner and accessories established to perpetuate locating the position of the corner:

A-6 Set Bay County Remon mon (5/8" x 24" rebar and brass cap marked with 3/16" drill hole) in mon box, 7± W of centerline of road, opposite fence line to E.
N 50° E 55.0' to Bay Co nail and tag in W face of 20" Corkscrew Willow.
N 36° E 107.05' to Bay Co nail and tag in W face of P.P.
S 75° W 18.70' to Bay Co nail and tag in N face of 18" Cottonwood.
S 38° W 92.17' to Wade-Trim nail and tag in SW face of 38" Willow.
N 87° E 60.50' to Bay Co nail and tag in S face of 14" Elm.
S 07° W 31.93' to Saginaw Co Remon mon in mon box cor (M-6) T13N, R3E.

Signed by Paul M. Ciosek
Surveyor's Michigan License No. 25835

Date 12/23/96

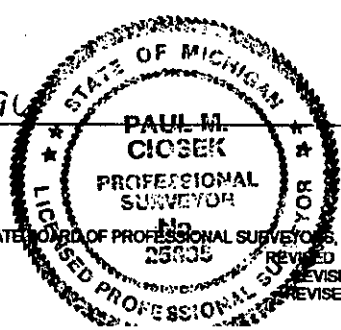

NOTE: Bearings are by compass & dist are hand chained
NOTE: See Bay County Remon Field Book
Pg. 2 & 60