

JAN 27 1999

BAY COUNTY REMONUMENTATION LAND CORNER RECORDATION CERTIFICATE Filing Requirement of Act 74, Mich. P.A. 1970

For corners in SECTION

BAY (County)

Located In: Corner Code #

- 1. Public Land Survey T 13N R 6E A-8
2. Property Controlling in Section S T R
3. Miscellaneous Property in Sec. S T R

4. Lot No. , Recorded Plat
5. Private Claims

I, DALE L. WINIECKE, in a field survey on SEPTEMBER 10, 1998 do hereby state that under requirements of P.A. 74, Michigan P.A. of 1970, the corner points mentioned in lines 1 and 2 above were in conformance with regulations and rules therefore as required in the current manual of survey instructions of the United States Department of the Interior, Bureau of Land Management or by a decree of a Court of Law and /or that the corner points mentioned in lines 3, 4 and 5 above were in conformance with the rules of the Michigan Board of Land Surveyors or by a Decree of a Court of Law; established, re-established, monumented, recovered, found as expressed below:

NOTE: Not more than 2 corners, all in the same town and range, may be recorded on this certificate.

A. Description of original monument and accessories and/or subsequent restoration:

A-8

SET POST, J. WAMPLER D.S., 1821
7" ELM N 89-1/2° W, 11 LINKS
10" ELM N 23° E, 19 LINKS

L.C.R.C., L.2, P.353, L MCGINNIS PS# 18999, (1977), , FOUND 2" IRON CERTIFICATE OF SURVEY, L.1579, P.2151, E. GOSS PS# 16040, (1979), FOUND 2" IRON

1997 SAGINAW CO. REMONUMENTATION LCRC, L. 2027, P. 469.

B. Description of corner evidence found and/or method applied in restoring or reestablishing corner:

A-8

FOUND 5/8" REBAR WITH SAGINAW COUNTY REMONUMENTATION CAP IN MONUMENT BOX.

IN 1997 SAGINAW CO. REMONUMENTATION FOUND 1-1/2" BAR. LOCATION VERIFIED FROM WITNESSES (L.C.R.C., L.2., P.353 AND SURVEY, L.1579, P.2151).

ACCEPTED MONUMENT AS THE BEST AVAILABLE EVIDENCE OF THE ORIGINAL CORNER.


C. Description of monument for corner and accessories established to perpetuate locating the position of the corner:

A-8

FOUND 5/8" X 18" REROD WITH SAGINAW COUNTY REMONUMENTATION CAP IN MONUMENT BOX.

N 45° E 21.20' TO 3/8" REROD WITH CAP #22438
S 25° E 25.64' TO 3/8" REROD WITH CAP #22438
S 30° W 21.98' TO 3/8" REROD WITH CAP #22438
S 80° W 23.90' TO CENTERLINE OF PIPELINE MARKER
N 25° W 18.99' TO 3/8" REROD WITH CAP #22438


APPROVED LAND CORNER
P.A. 345 OF 1990 - Bay County
Date 12 Nov 98
M.J.M.
Michael MacDonald P.S.
County Representative

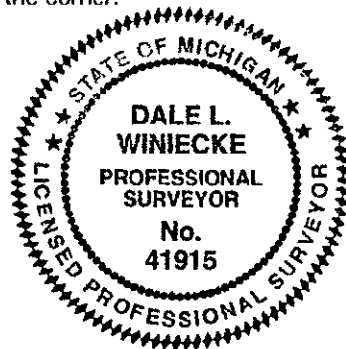

Signed by Dale Winiecke

Date 12/30/98

Surveyor's Michigan License No. 41915

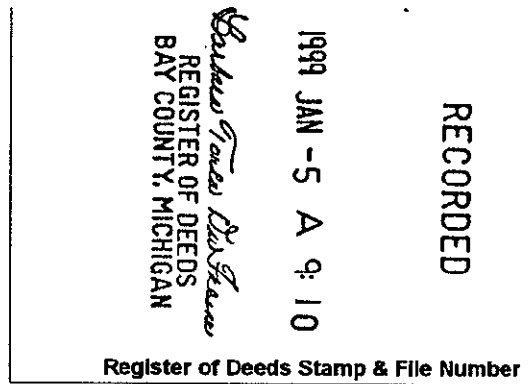

Grid table with columns A-M and rows 1-13, containing numbers 1-36.