

MAR 17 1999

**BAY COUNTY REMONUMENTATION
LAND CORNER RECORDATION CERTIFICATE
Filing Requirement of Act 74, Mich. P.A. 1970**

For corners in

<u>BAY</u> <small>(County)</small>	<u>SECTION</u>	Located In:	Corner Code #
1. Public Land Survey		<u>T 13N R 6E</u>	<u>A-10</u>
		T _____ R _____	_____
		T _____ R _____	_____
		T _____ R _____	_____
2. Property Controlling in Section	S _____	T _____ R _____	_____
	S _____	T _____ R _____	_____
3. Miscellaneous Property in Sec.	S _____	T _____ R _____	_____
	S _____	T _____ R _____	_____

Richard Thomas Day
**REGISTER OF DEEDS
BAY COUNTY, MICHIGAN**

1999 JAN -5 A 9:10

RECORDED

Register of Deeds Stamp & File Number

4. Lot No. _____, Recorded Plat _____
5. Private Claims _____

I, DALE L. WINIECKE, in a field survey on SEPTEMBER 10, 1998 do hereby state that under requirements of P.A. 74, Michigan P.A. of 1970, the corner points mentioned in lines 1 and 2 above were in conformance with regulations and rules therefore as required in the current manual of survey instructions of the United States Department of the Interior, Bureau of Land Management or by a decree of a Court of Law and /or that the corner points mentioned in lines 3, 4 and 5 above were in conformance with the rules of the Michigan Board of Land Surveyors or by a Decree of a Court of Law; established, re-established, monumented, recovered, found as expressed below:

NOTE: Not more than 2 corners, all in the same town and range, may be recorded on this certificate.

A. Description of original monument and accessories and/or subsequent restoration:

A-10
SET POST, J. WAMPLER D.S., 1821
8" ASH N 80° E 2 LINKS
8" ASH N 30° E 5 LINKS

1960, EDMANDS ENGINEERING, CONSUMERS POWER RIGHT OF WAY SURVEY, SET 3/8" REROD

CERTIFICATE OF SURVEY, L.1585, P.719, M. MACDONALD PS# 22438, (1980), , FOUND 3/8" REROD
CERTIFICATE OF SURVEY, L.1734, P.676, L. MCGINNIS PS# 18999, (1988), FOUND 3/8" REROD

1997 SAGINAW CO. REMONUMENTATION LCRC L. 2027, P. 471.

B. Description of corner evidence found and/or method applied in restoring or reestablishing corner:


A-10
FOUND 5/8" REBAR WITH SAGINAW COUNTY REMONUMENTATION CAP
IN 1997 SAGINAW CO. REMONUMENTATION RESET CORNER USING SINGLE PROPORTIONAL MEASUREMENT BETWEEN M-9 AND M-11. SINGLE PROPORTION MEASUREMENT WAS USED IN THE 1968 EDMANDS ENGINEERING CONSUMERS POWER RIGHT OF WAY SURVEY. THE HALF MILE DISTANCE IN THE 1968 SURVEY WAS 2633.50' AND THE HALF MILE DISTANCE USED FOR REMONUMENTATION IS 2633.87'. THIS CORNER WAS ACCEPTED AS THE BEST AVAILABLE EVIDENCE FOR THE POSITION OF THE ORIGINAL CORNER.

ALSO FOUND IN THE AREA WAS A 3/8" REROD 53.91' S 85° E OF THE RESET CORNER. THIS CORNER WAS USED IN BAY COUNTY SURVEY L.1135 P.271 AND BAY COUNTY SURVEY, L.1135, P.285. ANOTHER 3/8" REROD WAS FOUND S 35° E 116.34' FROM THE RESET CORNER. THIS CORNER WAS NOT USED IN ANY RECORDED INFORMATION.

C. Description of monument for corner and accessories established to perpetuate locating the position of the corner:

A-10
FOUND 5/8" X 18" REROD WITH SAGINAW COUNTY REMONUMENTATION CAP 20" BELOW THE SURFACE OF FARM FIELD.
S 85° E 53.91' TO 3/8" REROD 4' EAST OF PHYSICAL CENTERLINE OF JONES ROAD
S 35° E 116.34' TO 3/8" REROD
S 15° E 102.68' TO CENTERLINE OF PIPELINE MARKER
S 4° W 221.00' TO NORTHEAST CORNER OF TOWER LEG
S 18° W 219.91' TO NORTHWEST CORNER OF TOWER LEG

APPROVED LAND CORNER
P.A. 345 OF 1990 - Bay County
Date 12 Nov 98
MJM
Michael MacDonald P.S.
County Representative

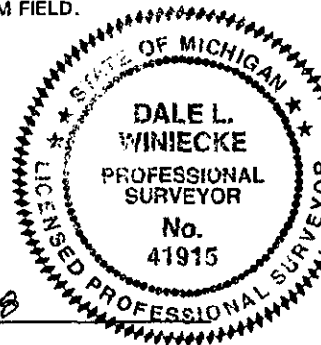

Signed by Dale Winiecke
Surveyor's Michigan License No. 41915

Date 12/20/98