

SECTION

BAY COUNTY REMONUMENTATION 1999
LAND CORNER RECORDATION CERTIFICATE
Filing Requirement of Act 74, Mich. P.A. 1970

For corners in

BAY
(County)

Located in: **MERRITT TOWNSHIP** Corner Code #

1. Public Land Survey T 13N R 6E B-9
T _____ R _____

2. Property Controlling S _____ T _____ R _____

3. Miscellaneous S _____ T _____ R _____
Property in Sec. S _____ T _____ R _____

RECORDED

1999 DEC 29 P 12:54

BAY COUNTY, MICHIGAN

REGISTER OF DEEDS

BAY COUNTY, MICHIGAN


Register of Deeds Stamp & File Number

4. Lot No. _____, Recorded Plat _____

5. Private Claims _____

I, BRIAN D FERGUSON, in a field survey on MAY, 19 99 do hereby state that under requirements of P.A. 74, Michigan P.A. of 1970, the corner points mentioned in lines 1 and 2 above were in conformance with regulations and rules therefore as required in the current manual of survey instructions of the United States Department of the Interior, Bureau of Land Management or by a decree of a Court of Law and/or that the corner points mentioned in lines 3, 4 and 5 above were in conformance with the rules of the Michigan Board of Land Surveyors or by a Decree of a Court of Law; established, re-established, monumented, recovered, found as expressed below:

NOTE: Not more than 2 corners, all in the same town and range, may be recorded on this certificate.

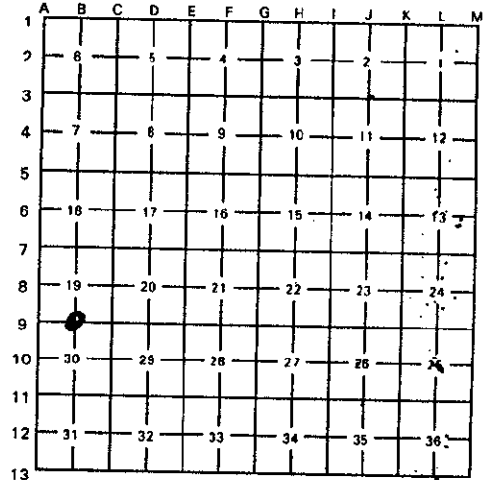

A. Description of original monument and accessories and/or subsequent restoration:

WOOD POST SET BY J. WAMPLER, DS, IN 1821. NO EVIDENCE OF ORIGINAL CORNER REMAINS.
LCRC BY BURGIN, L002, P658, IN 1991 (S10E-59.9'-PK NW FCE U.P. : NW-94.74'-SE COR HSE #758 :
NNW-51.5'-FCE 12" MAPLE : N-6'-CTR OF ROAD
COS BY MACDONALD, L832, P153
COS BY CIOSEK, L1057, P 965
COS BY BURGIN, L1135, P271 & L1135, P285

B. Description of corner evidence found and/or method applied in restoring or reestablishing corner:


FOUND 3/8" ROD AT LOCATION PER LCRC AND COS'S.
MEASURED 2561.64 TO A-9. COS L1135, P271 2561.77 REC
MEASURED 2631.46' TO C-9. COS L1057, P965 2631.72' REC

ACCEPTED AS THE BEST AVAILABLE EVIDENCE OF THE LOCATION OF THE ORIGINAL CORNER

C. Description of monument for corner and accessories established to perpetuate locating the position of the corner:

SET 5/8" RE-BAR W / BAY COUNTY REMON. BRASS CAP & NO. 26454 IN MONUMENT BOX
S10E 59.90' PK NAIL NW FCE PWR POLE (REC 59.8')
N55W 94.78' SE COR HSE #758 (REC 94.74')
N70W 51.5' FCE 12" MAPLE TREE (REC 51.5')
N45E 39.84' 1/2 REBAR 4' NORTH OF ROAD
S45E 33.33' 1/2 REBAR 3' SOUTH OF ROAD

Signed by Brian D Ferguson Date December 15, 1999
Surveyor's Michigan License No. 26454

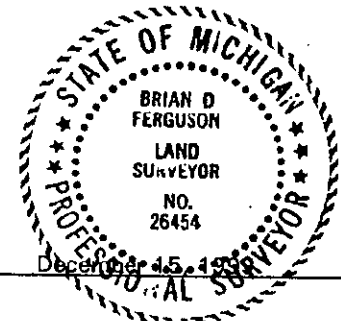

APPROVED LAND CORNER
P.A. 345 OF 1990 - Bay County
Date 6-24-99
MM
Michael MacDonald P.S.

FORM APPROVED BY MICHIGAN STATE BOARD OF PROFESSIONAL SURVEYORS, JAN. 28, 1971
REVISED MAY 14, 1975
REVISED JAN., 1983
REVISED OCT., 1995

004 348