

RF

2000

BAY COUNTY REMONUMENTATION 1999
LAND CORNER RECORDATION CERTIFICATE
Filing Requirement of Act 74, Mich. P.A. 1970

SECTION

For corners in

MERRITT TOWNSHIP

BAY Located in: Corner Code #
(County)

- 1. Public Land Survey T 13N R 6E B-13
T _____ R _____
- 2. Property Controlling S _____ T _____ R _____
- 3. Miscellaneous S _____ T _____ R _____
- Property in Sec. S _____ T _____ R _____

1999 DEC 29 P 12: 51
 REGISTER OF DEEDS
 BAY COUNTY, MICHIGAN
 Register of Deeds Stamp & File Number
 RECORDED

- 4. Lot No. _____, Recorded Plat _____
- 5. Private Claims _____

I, BRIAN D FERGUSON, in a field survey on MAY, 19 99 do hereby state that under requirements of P.A. 74, Michigan P.A. of 1970, the corner points mentioned in lines 1 and 2 above were in conformance with regulations and rules therefore as required in the current manual of survey instructions of the United States Department of the Interior, Bureau of Land Management or by a decree of a Court of Law and/or that the corner points mentioned in lines 3, 4 and 5 above were in conformance with the rules of the Michigan Board of Land Surveyors or by a Decree of a Court of Law; established, re-established, monumented, recovered, found as expressed below:

NOTE: Not more than 2 corners, all in the same town and range, may be recorded on this certificate.

1	A	B	C	D	E	F	G	H	I	J	K	L	M
2		6		5		4		3		2		1	
3													
4		7		8		9		10		11		12	
5													
6		18		17		16		15		14		13	
7													
8		19		20		21		22		23		24	
9													
10		30		29		28		27		26		25	
11													
12		31		32		33		34		35		36	
13													

A. Description of original monument and accessories and/or subsequent restoration:

WOOD POST SET BY J. WAMPLER, DS, IN 1821. NO EVIDENCE OF ORIGINAL CORNER REMAINS.
NO LCRC'S FOR THIS CORNER
NO COS'S FOR THIS CORNER

B. Description of corner evidence found and/or method applied in restoring or reestablishing corner:


FOUND 1" ROD IN SOUTH SHOULDER ROAD
CORNER WAS REFERENCED IN SAGINAW COUNTY REMONUMENTATION OF B-1, T12N-R6E
MEASURED 29.03' (REC. 28.99') BY LCRC IN SAGINAW COUNTY
A-13 TO C-13 MEASURES 5260.88' (GLO REC. IS 79.77 CHAINS) PRO-RATA TO A-13 IS 2622.86'
MEASURED 2622.77'. PRO-RATA TO C-13 IS 2638.02', MEASURED 2638.11'. EXISTING CORNER
IS AT GLO PRO-RATA LOCATION
ACCEPTED AS THE BEST AVAILABLE EVIDENCE OF THE LOCATION OF THE ORIGINAL CORNER

C. Description of monument for corner and accessories established to perpetuate locating the position of the corner:

SET 5/8" RE-BAR W / BAY COUNTY REMON. BRASS CAP & NO. 26454 IN MONUMENT BOX
N55W 24.10' SET REBAR 6" NORTH OF ROAD
N45E 25.28' SET REBAR 6" NORTH OF ROAD
S40E 16.86' SET REBAR 6" SOUTH OF ROAD
S75W 30.66' SET REBAR 6" SOUTH OF ROAD

Signed by Brian D Ferguson
Surveyor's Michigan License No. 26454

Date December 15, 1999

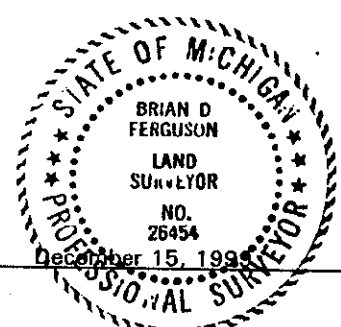

APPROVED LAND CORNER
P.A. 345 OF 1990 - Bay County
Date 11/18/99
MM
Michael MacDonald P.S.
County Registration

FORM APPROVED BY MICHIGAN STATE BOARD OF PROFESSIONAL SURVEYORS, JAN. 28, 1971
REVISED MAY 14, 1975
REVISED JAN., 1983
REVISED OCT., 1995

004 350