

RE

SECTION

BAY COUNTY REMONUMENTATION 1999
LAND CORNER RECORDATION CERTIFICATE
Filing Requirement of Act 74, Mich. P.A. 1970

For corners in

BAY Located in: MERRITT TOWNSHIP Corner Code #
 (County)

1. Public Land Survey T 13N R 6E C-7
 T _____ R _____

2. Property Controlling S _____ T _____ R _____

3. Miscellaneous S _____ T _____ R _____
 Property in Sec. S _____ T _____ R _____

1999 DEC 29 P 12: 53
 REGISTER OF DEEDS
 BAY COUNTY, MICHIGAN
 Recorder's Office
 REGISTERED
 Register of Deeds Stamp & File Number

4. Lot No. _____, Recorded Plat _____
 5. Private Claims _____

I, BRIAN D FERGUSON, in a field survey on MAY, 1999 do hereby state that under requirements of P.A. 74, Michigan P.A. of 1970, the corner points mentioned in lines 1 and 2 above were in conformance with regulations and rules therefore as required in the current manual of survey instructions of the United States Department of the Interior, Bureau of Land Management or by a decree of a Court of Law and/or that the corner points mentioned in lines 3, 4 and 5 above were in conformance with the rules of the Michigan Board of Land Surveyors or by a Decree of a Court of Law; established, re-established, monumented, recovered, found as expressed below:

1	A	B	C	D	E	F	G	H	I	J	K	L	M
2		6		5		4		3		2			
3													
4		7		8		9		10		11		12	
5													
6		18		17		16		15		14		13	
7													
8		19		20		21		22		23		24	
9													
10		30		29		28		27		26		25	
11													
12		31		32		33		34		35		36	
13													

NOTE: Not more than 2 corners, all in the same town and range, may be recorded on this certificate.

A. Description of original monument and accessories and/or subsequent restoration:

WOOD POST SET BY J. WAMPLER, DS, IN 1821. NO EVIDENCE OF ORIGINAL CORNER REMAINS.
 LCRC BY ERICKSON, L002, P534, IN 1981 (S22E-50.99'-TOP CTR F HYD
 COS BURGIN, L1308, P919 & 1150, P704 & L1343, P530 (NE 47.9 TO TAG IN U.P., SE 51.0' TO CTR FIRE HYD
 COS WADE-TRIM, L1415, P443
 COS MCGINNIS, L815, P347
 COS MACDONALD L832, P170

B. Description of corner evidence found and/or method applied in restoring or reestablishing corner:

FOUND 5/8" ROD IN MONUMENT BOX W/O COVER PER LCRC AND COS'S
 MEASURED 2649.53' TO B-7 (REC 2648.88' L 1415 P443)
 MEASURED 2607.76 TO D-7 (REC 2608.2' L832 P170)
 MEASURED 2621.89' TO C-8 (REC 2621.72' L 1343 P530)


ACCEPTED AS THE BEST AVAILABLE EVIDENCE OF THE LOCATION OF THE ORIGINAL CORNER

C. Description of monument for corner and accessories established to perpetuate locating the position of the corner:

SET 5/8" RE-BAR W / BAY COUNTY REMON. BRASS CAP & NO. 26454 IN MONUMENT BOX
 S45E 51.05' TOP CTR HYDRANT (REC 51.0' & 50.99')
 S45E 56.15' N&T W FCE PWR POLE (REC 55.9')
 N55W 46.89 MDOT TAG IN PWR POLE (REC 46.8')
 N45E 47.89' MDOT TAG IN PWR POLE (REC 47.9')

Signed by Brian D Ferguson
 Surveyor's Michigan License No. 26454

Date December 15 1999

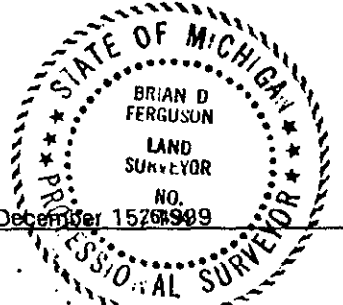

APPROVED LAND CORNER
 P.A. 345 OF 1990 - Bay County
 Date 6.24.99
MM
 Michael MacDonald P.S.

004 343