

SECTION

BAY COUNTY REMONUMENTATION 1999
LAND CORNER RECORDATION CERTIFICATE
Filing Requirement of Act 74, Mich. P.A. 1970

For corners in


<u>BAY</u> (County)	Located in:	MERRITT TOWNSHIP	Corner Code #
1. Public Land Survey	T <u>13N</u> R <u>6E</u>		<u>C-8</u>
	T _____ R _____		_____
2. Property Controlling	S _____ T _____ R _____		_____
3. Miscellaneous	S _____ T _____ R _____		_____
Property in Sec.	S _____ T _____ R _____		_____

REGISTER OF DEEDS
 BAY COUNTY, MICHIGAN
 1999 DEC 29 P 12: 53
 Recorder of Deeds Stamp & File Number

RECORDED

4. Lot No. _____, Recorded Plat _____
5. Private Claims _____

I, BRIAN D FERGUSON, in a field survey on MAY, 19 99 do hereby state that under requirements of P.A. 74, Michigan P.A. of 1970, the corner points mentioned in lines 1 and 2 above were in conformance with regulations and rules therefore as required in the current manual of survey instructions of the United States Department of the Interior, Bureau of Land Management or by a decree of a Court of Law and/or that the corner points mentioned in lines 3, 4 and 5 above were in conformance with the rules of the Michigan Board of Land Surveyors or by a Decree of a Court of Law; established, re-established, monumented, recovered, found as expressed below:

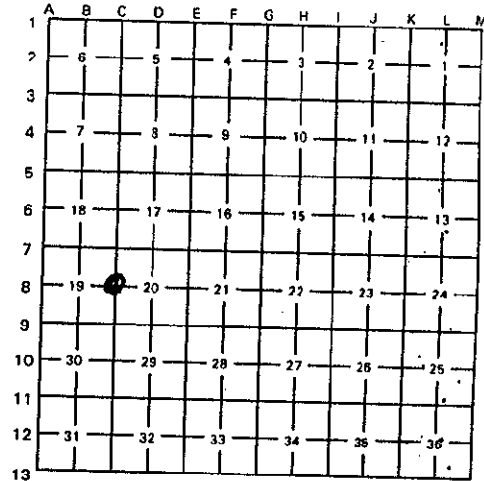

NOTE: Not more than 2 corners, all in the same town and range, may be recorded on this certificate.

A. Description of original monument and accessories and/or subsequent restoration:

WOOD POST SET BY J. WAMPLER, DS, IN 1821. NO EVIDENCE OF ORIGINAL CORNER REMAINS.
 LCRC BY MCGINNIS, L02 P353, IN 1977 (WITNESS NO LONGER REMAINS)
 COS BY BURGIN L1150 P704 : L1308 P410
 COS BY MCGINNIS L815 P348, L815 P347, L968 P482, L853 P616
 COS BY EDMANDS ENG L767 P549
 COS BY MACDONALD L90 P656, L832 P170, L1033 P34,

B. Description of corner evidence found and/or method applied in restoring or reestablishing corner:

FOUND 1/2" ROD IN MONUMENT BOX PER LCRC AND COS'S
 MEASURED 2621.89' TO C-7 (REC 2622.34')
 MEASURED 2632.20' TO C-9 (REC 2632.25')


ACCEPTED AS THE BEST AVAILABLE EVIDENCE OF THE LOCATION OF THE ORIGINAL CORNER

C. Description of monument for corner and accessories established to perpetuate locating the position of the corner:

SET 5/8" RE-BAR W / BAY COUNTY REMON. BRASS CAP & NO. 26454 IN MONUMENT BOX
 S85E 35.23' TOP CTR HYDRANT (REC 35.0')
 N85E 23.53' TAG IN PWR POLE (REC 23.65')
 N15W 12.0' SET NAIL EDGE OF BIT
 S15W 12.0' SET NAIL EDGE OF BIT

Signed by Brian D Ferguson
 Surveyor's Michigan License No. 26454

Date December 15, 1999

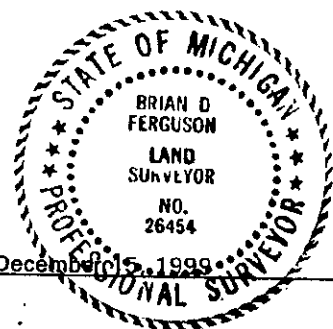

APPROVED LAND CORNER
 P.A. 345 OF 1990 - Bay County
 Date 6.24.99
MM
 Michael MacDonald P.S.