

MAR 9 2000

SECTION

BAY COUNTY REMONUMENTATION 1999
LAND CORNER RECORDATION CERTIFICATE
Filing Requirement of Act 74, Mich. P.A. 1970

For corners in


MERRITT TOWNSHIP

<u>BAY</u> (County)	Located in:	Corner Code #
1. Public Land Survey	T <u>13N</u> R <u>6E</u>	<u>C-9</u>
	T _____ R _____	_____
2. Property Controlling	S _____ T _____ R _____	_____
3. Miscellaneous	S _____ T _____ R _____	_____
Property in Sec.	S _____ T _____ R _____	_____

REGISTER OF DEEDS
 BAY COUNTY, MICHIGAN
 1999 DEC 29 P 12:53
 Register of Deeds Stamp & File Number

4. Lot No. _____, Recorded Plat _____
 5. Private Claims _____

I, BRIAN D FERGUSON, in a field survey on MAY, 19 99 do hereby state that under requirements of P.A. 74, Michigan P.A. of 1970, the corner points mentioned in lines 1 and 2 above were in conformance with regulations and rules therefore as required in the current manual of survey instructions of the United States Department of the Interior, Bureau of Land Management or by a decree of a Court of Law and/or that the corner points mentioned in lines 3, 4 and 5 above were in conformance with the rules of the Michigan Board of Land Surveyors or by a Decree of a Court of Law; established, re-established, monumented, recovered, found as expressed below:

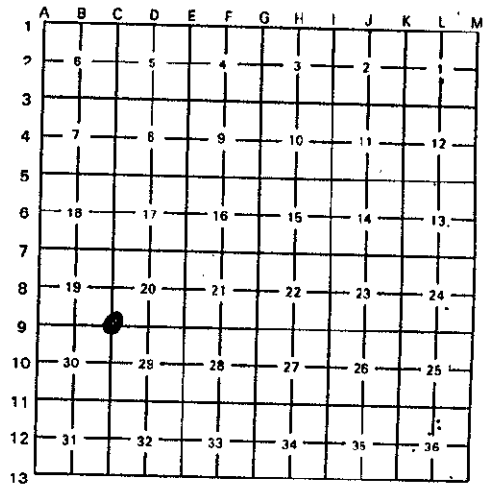

NOTE: Not more than 2 corners, all in the same town and range, may be recorded on this certificate.

A. Description of original monument and accessories and/or subsequent restoration:

WOOD POST SET BY J. WAMPLER, DS, IN 1821. NO EVIDENCE OF ORIGINAL CORNER REMAINS.
 LCRC BY MCGINNIS, L02 P353, IN 1977 (NO WITNESSES REMAIN)
 COS BY EDMANDS ENG, L767 P549 (S60E-64.69'-P.POLE)
 COS BY MACDONALD, L856 P374, L1033 P34
 COS BY MCGINNIS, L968 P482
 COS BY CIOSEK, L1057 P965


B. Description of corner evidence found and/or method applied in restoring or reestablishing corner:

FOUND 3/8" ROD IN INTERSECTION OF ROADS. SAME TYPE OF MATERIAL AS LCRC
 LOCATION AGREES WITH WITNESSES FROM COS'S
 MEASURED 2631.46' TO B-9 (REC 2631.72' L1057 P965)
 MEASURED 2632.20' TO C-8 (REC 2632.25' L968 P482)
 MEASURED 2616.11' TO D-9 (REC 2616.3' L856 P374)

ACCEPTED AS THE BEST AVAILABLE EVIDENCE OF THE LOCATION OF THE ORIGINAL CORNER

C. Description of monument for corner and accessories established to perpetuate locating the position of the corner:

SET 5/8" RE-BAR W / BAY COUNTY REMON. BRASS CAP & NO. 26454 IN MONUMENT BOX
 S60E 64.75' MAG NAIL SW FCE PWR POLE (REC. 64.69')
 S42W 45.68' FCE ROAD SIGN POST
 S45W 57.34' NAIL N FCE PWR POLE (REC 57.15' FCE PWR POLE)
 N45E 48.04' MAG NAIL W FCE WOOD POST

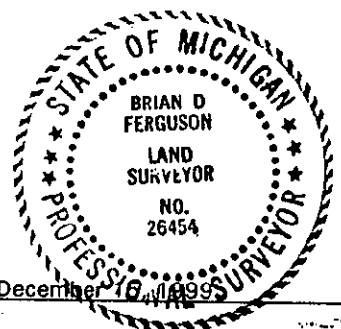

Signed by Brian D Ferguson Date December 16, 1999
 Surveyor's Michigan License No. 26454

APPROVED LAND CORNER
 P.A. 345 OF 1990 - Bay County
 Date 6.24.99
MM
 Michael MacDonald P.S.

004 341