

SECTION

BAY COUNTY REMONUMENTATION 1999  
LAND CORNER RECORDATION CERTIFICATE  
Filing Requirement of Act 74, Mich. P.A. 1970

For corners in

MERRITT TOWNSHIP

<u>BAY</u> (County)	Located in:	Corner Code #
1. Public Land Survey	T <u>13N</u> R <u>6E</u>	<u>C-10</u>
	T _____ R _____	_____
2. Property Controlling	S _____ T _____ R _____	_____
3. Miscellaneous	S _____ T _____ R _____	_____
Property in Sec.	S _____ T _____ R _____	_____

BAY COUNTY REGISTER OF DEEDS  
BAY COUNTY, MICHIGAN


1999 DEC 29 P 12:54

RECORDED

Register of Deeds Stamp & File Number

- 4. Lot No. \_\_\_\_\_, Recorded Plat \_\_\_\_\_
- 5. Private Claims \_\_\_\_\_

I, BRIAN D FERGUSON, in a field survey on MAY, 19 99 do hereby state that under requirements of P.A. 74, Michigan P.A. of 1970, the corner points mentioned in lines 1 and 2 above were in conformance with regulations and rules therefore as required in the current manual of survey instructions of the United States Department of the Interior, Bureau of Land Management or by a decree of a Court of Law and/or that the corner points mentioned in lines 3, 4 and 5 above were in conformance with the rules of the Michigan Board of Land Surveyors or by a Decree of a Court of Law; established, re-established, monumented, recovered, found as expressed below:

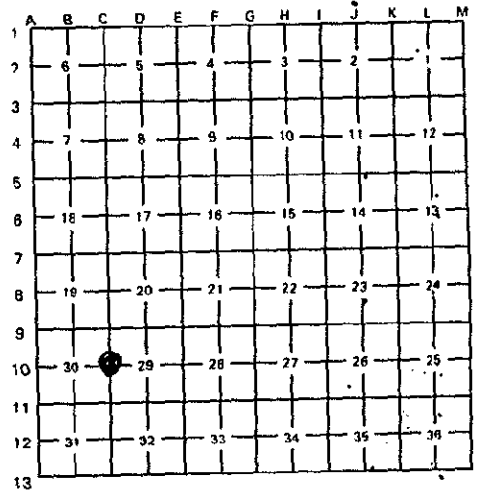

NOTE: Not more than 2 corners, all in the same town and range, may be recorded on this certificate.

A. Description of original monument and accessories and/or subsequent restoration:

WOOD POST SET BY J. WAMPLER, DS, IN 1821. NO EVIDENCE OF ORIGINAL CORNER REMAINS.  
LCRC BY BURGIN, L002 P658, IN 1991 (ALL WITNESSES CHECK)  
COS BY MACDONALD, L1027 P70, L832 P151  
COS BY BURGIN, L1576 P876, L1135 P285

B. Description of corner evidence found and/or method applied in restoring or reestablishing corner:


FOUND PK NAIL PER LCRC AND COS'S  
MEASURED 2630.9' TO C-1 (REC. 2630.90' L1027 P70)

ACCEPTED AS THE BEST AVAILABLE EVIDENCE OF THE LOCATION OF THE ORIGINAL CORNER

C. Description of monument for corner and accessories established to perpetuate locating the position of the corner:

SET 5/8" RE-BAR W / BAY COUNTY REMON. BRASS CAP & NO. 26454 IN MONUMENT BOX  
S85E 28.30' N END 12" CONC CULVERT (REC 28.3')  
S35E 40.67' S END 12" CONC CULVERT (REC 40.5' & 40.8')  
N40W 41.30' N END 12" CONC CULVERT (REC 41.3' & 41.40')  
EAST 18.36' SET 1/2 REBAR 7.70' EAST OF EAST EDGE OF ROAD

Signed by Brian D Ferguson Date December 29, 1999  
Surveyor's Michigan License No. 26454

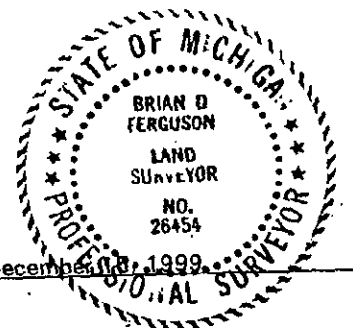

APPROVED LAND CORNER  
P.A. 345 OF 1990 - Bay County  
Date 11.07.99  
MM  
Michael MacDonald P.S.

FORM APPROVED BY MICHIGAN STATE BOARD OF PROFESSIONAL SURVEYORS, JAN. 28, 1971  
REVISED MAY 14, 1975  
REVISED JAN., 1983  
REVISED OCT., 1995

004 347