

SECTION

BAY COUNTY REMONUMENTATION 1999
LAND CORNER RECORDATION CERTIFICATE
Filing Requirement of Act 74, Mich. P.A. 1970

For corners in

BAY
(County)

MERRITT TOWNSHIP

Located in: Corner Code #

- 1. Public Land Survey T 13N R 6E C-11
- 2. Property Controlling S T R
- 3. Miscellaneous S T R
- Property in Sec. S T R

RECORDED

1999 DEC 29 P 12:53

BAY COUNTY, MICHIGAN

REGISTER OF DEEDS

BAY COUNTY, MICHIGAN

Register of Deeds Stamp & File Number

- 4. Lot No. _____, Recorded Plat _____
- 5. Private Claims _____

I, BRIAN D FERGUSON, in a field survey on MAY, 1999 do hereby state that under requirements of P.A. 74, Michigan P.A. of 1970, the corner points mentioned in lines 1 and 2 above were in conformance with regulations and rules therefore as required in the current manual of survey instructions of the United States Department of the Interior, Bureau of Land Management or by a decree of a Court of Law and/or that the corner points mentioned in lines 3, 4 and 5 above were in conformance with the rules of the Michigan Board of Land Surveyors or by a Decree of a Court of Law; established, re-established, monumented, recovered, found as expressed below:

NOTE: Not more than 2 corners, all in the same town and range, may be recorded on this certificate.

A	B	C	D	E	F	G	H	I	J	K	L	M
1												
2	6		5		4		3		2		1	
3												
4	7		8		9		10		11		12	
5												
6	18		17		16		15		14		13	
7												
8	19		20		21		22		23		24	
9												
10	30		29		28		27		26		25	
11												
12	31		32		33		34		35		36	
13												

A. Description of original monument and accessories and/or subsequent restoration:

WOOD POST SET BY J. WAMPLER, DS, IN 1821. NO EVIDENCE OF ORIGINAL CORNER REMAINS.
 LCRC BY DE LA MATER, L001 P49, IN 1971
 LCRC BY MCGINNIS, L001 P89
 COS BY BURGIN, L1576 P876
 COS BY DE LA MATER, L652 P340
 COS BY MACDONALD, L1027 P70

B. Description of corner evidence found and/or method applied in restoring or reestablishing corner:

FOUND 5/8" ROD IN INTERSECTION OF ROADS. AGREES WITH LOCATION FROM COS'S
 MEASURED 2630.90' TO C-10 (REC 2630.90 L1027 P70)
 MEASURED 2632.84' TO C-12 (REC 2633.33' L652 P340)
 MEASURED 2643.20' TO B-11 (REC 2643.5' L781 P544)


ACCEPTED AS THE BEST AVAILABLE EVIDENCE OF THE LOCATION OF THE ORIGINAL CORNER

C. Description of monument for corner and accessories established to perpetuate locating the position of the corner:

SET 5/8" RE-BAR W / BAY COUNTY REMON. BRASS CAP & NO. 26454 IN MONUMENT BOX
 S55E 66.55' N&T S FCE PWR POLE (REC 66.56' WIT TAG IN UTIL POLE, L781 P544)
 S50W 46.83' NAIL IN SE FCE BELL BOX GUARD POST (REC 46.9' L1576 P876)
 S45E 129.53' NW COR GAR. FNDN #2515 (REC 129.5' L1576 P876)
 N45E 49.87' TOP CTR TELE RISER

Signed by Brian D Ferguson
 Surveyor's Michigan License No. 26454

Date December 15, 1999

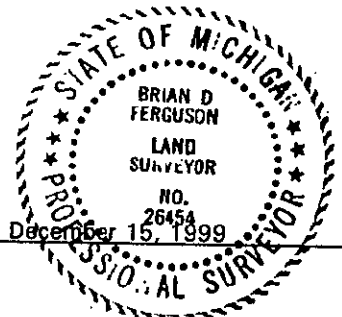

APPROVED LAND CORNER
 P.A. 345 OF 1990 - Bay County
 Date 8.05.99
MN
 Michael MacDonald P.S.
 County Deponent

FORM APPROVED BY MICHIGAN STATE BOARD OF PROFESSIONAL SURVEYORS, JAN. 28, 1971
 REVISED MAY 14, 1975
 REVISED JAN., 1983
 REVISED OCT., 1995