RE[illegible]Y

[illegible] 2000

SECTION

BAY COUNTY REMONUMENTATION 1999
LAND CORNER RECORDATION CERTIFICATE
Filing Requirement of Act 74, Mich. P.A. 1970

For corners in

MERRITT TOWNSHIP

BAY (County) Located in: Corner Code #

1. Public Land Survey T 13N R 6E C-13
   T____ R____
2. Property Controlling S____ T____ R____
3. Miscellaneous S____ T____ R____
   Property in Sec. S____ T____ R____

RECORDED
1999 DEC 29 P 12: 53
Barbara Ann Kirkman
REGISTER OF DEEDS
BAY COUNTY, MICHIGAN

Register of Deeds Stamp & File Number

4. Lot No._____, Recorded Plat_____
5. Private Claims_____

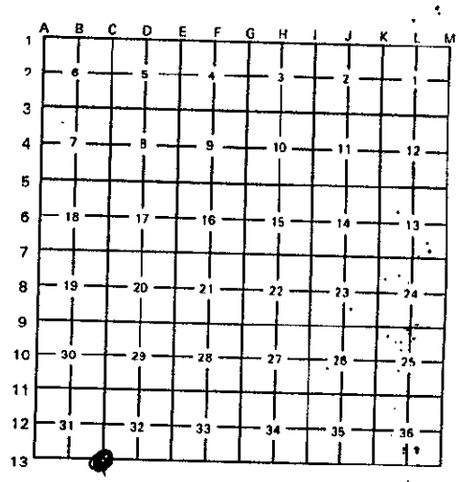

I, BRIAN D FERGUSON, in a field survey on MAY, 19 99 do hereby state that under requirements of P.A. 74, Michigan P.A. of 1970, the corner points mentioned in lines 1 and 2 above were in conformance with regulations and rules therefore as required in the current manual of survey instructions of the United States Department of the Interior, Bureau of Land Management or by a decree of a Court of Law and/or that the corner points mentioned in lines 3, 4 and 5 above were in conformance with the rules of the Michigan Board of Land Surveyors or by a Decree of a Court of Law; established, re-established, monumented, recovered, found as expressed below:

NOTE: Not more than 2 corners, all in the same town and range, may be recorded on this certificate.

A. Description of original monument and accessories and/or subsequent restoration:

WOOD POST SET BY J. WAMPLER, DS, IN 1821. NO EVIDENCE OF ORIGINAL CORNER REMAINS.
LCRC BY MCGINNIS, L001 P83, IN 1972
COS BY BURGIN, L1096 P427
COS BY MCGINNIS, L812 P238

B. Description of corner evidence found and/or method applied in restoring or reestablishing corner:

FOUND "T" IRON PER LCRC & COS'S
MEASURED 2607.71' TO D-13 (REC 2608.0', L1096 P427)
LOCATION AGREES WITH LCRC L7 P205, SAGINAW COUNTY REMON

ACCEPTED AS THE BEST AVAILABLE EVIDENCE OF THE LOCATION OF THE ORIGINAL CORNER

C. Description of monument for corner and accessories established to perpetuate locating the position of the corner:

SET 5/8" RE-BAR W / BAY COUNTY REMON. BRASS CAP & NO. 26454 IN MONUMENT BOX
WEST 27.72' BRASS CAP, SAG. CO. REMON (REC 27.75', L1096 P427
N45E 31.20' N&T S FCE PWR POLE (REC 31.1' L1096 P427)
N60W 57.1' FCE ROAD SIGN POST (REC 57.1' L812 P238)
S55W 18.02' NAIL IN WOOD GUARD RAIL POST

Signed by Brian D Ferguson Date December 14, 1999
Surveyor's Michigan License No. 26454

STATE OF MICHIGAN
BRIAN D FERGUSON
LAND SURVEYOR
NO. 26454
PROFESSIONAL SURVEYOR

APPROVED LAND CORNER
P.A. 345 OF 1990 - Bay County
Date 6.24.99
MM
Michael MacDonald P.S.
County Representative

FORM APPROVED BY MICHIGAN STATE BOARD OF PROFESSIONAL SURVEYORS, JAN. 28, 1971
REVISED MAY 14, 1975
REVISED JAN., 1983
REVISED OCT., 1995