

**BAY COUNTY REMONUMENTATION 1999
LAND CORNER RECORDATION CERTIFICATE
Filing Requirement of Act 74, Mich. P.A. 1970**

For corners in SECTION _____


MERRITT TOWNSHIP

<u> </u> BAY (County)	Located in:	Corner Code #
1. Public Land Survey	T <u>13N</u> R <u>6E</u>	<u>D-11</u>
	T <u> </u> R <u> </u>	<u> </u>
2. Property Controlling	S <u> </u> T <u> </u> R <u> </u>	<u> </u>
3. Miscellaneous	S <u> </u> T <u> </u> R <u> </u>	<u> </u>
Property in Sec.	S <u> </u> T <u> </u> R <u> </u>	<u> </u>

Brian D. Ferguson
 REGISTER OF DEEDS
 BAY COUNTY, MICHIGAN
 1999 DEC 29 P 12:53
RECORDED
 Register of Deeds Stamp & File Number

4. Lot No. _____, Recorded Plat _____
 5. Private Claims _____

I, BRIAN D FERGUSON, in a field survey on MAY, 19 99 do hereby state that under requirements of P.A. 74, Michigan P.A. of 1970, the corner points mentioned in lines 1 and 2 above were in conformance with regulations and rules therefore as required in the current manual of survey instructions of the United States Department of the Interior, Bureau of Land Management or by a decree of a Court of Law and/or that the corner points mentioned in lines 3, 4 and 5 above were in conformance with the rules of the Michigan Board of Land Surveyors or by a Decree of a Court of Law; established, re-established, monumented, recovered, found as expressed below:

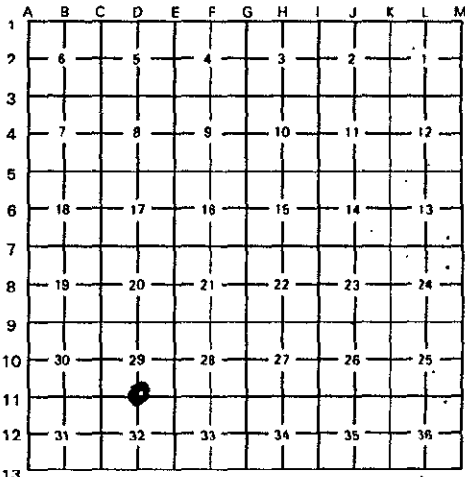

NOTE: Not more than 2 corners, all in the same town and range, may be recorded on this certificate.

A. Description of original monument and accessories and/or subsequent restoration:

WOOD POST SET BY J. WAMPLER, DS, IN 1821. NO EVIDENCE OF ORIGINAL CORNER REMAINS.
 LCRC BY DELAMATER, L001 P49, IN 1971 (1" IRON)
 LCRC BY MCGINNIS, L001 P81, IN 1972 (1" PENTAGONAL BAR)
 LCRC BY MACDONALD, L02 P401, IN 1976 (PK NAIL)
 COS BY EDMANDS ENG., L888 P231, L885 P857
 COS BY SPICER ENG, L1107 P551

B. Description of corner evidence found and/or method applied in restoring or reestablishing corner:


FOUND PK NAIL PER LCRC L02 P401 AND COS'S
 MEASURED 2617.97' TO C-11 (REC 2617.3' L716 P618)

ACCEPTED AS THE BEST AVAILABLE EVIDENCE OF THE LOCATION OF THE ORIGINAL CORNER

C. Description of monument for corner and accessories established to perpetuate locating the position of the corner:

SET 5/8" RE-BAR W / BAY COUNTY REMON. BRASS CAP & NO. 26454 IN MONUMENT BOX
 N25E 102.45' SW COR HSE (REC 102.45 LCRC L02 P401)
 NORTH 31.82' FCE PWR POLE (REC 32.12' L1107 P551)
 S35W 40.00' CTR TELE RISER (REC 39.67' L1107 P551)
 N45W 125.84' SE COR HSE (REC 125.84' L702 P159)

Signed by Brian D Ferguson Date December 15, 1999
 Surveyor's Michigan License No. 26454

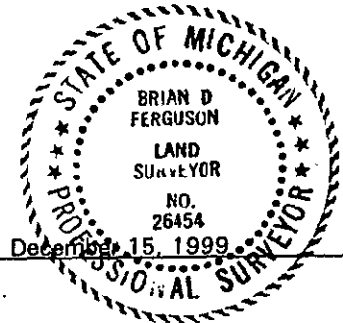

APPROVED LAND CORNER
 P.A. 345 OF 1990 - Bay County
 Date 8.05.99
MM
 Michael MacDonald P.S.