

SECTION

BAY COUNTY REMONUMENTATION 1999
LAND CORNER RECORDATION CERTIFICATE
Filing Requirement of Act 74, Mich. P.A. 1970

For corners in

MERRITT TOWNSHIP

<u>BAY</u> (County)	Located in:	Corner Code #
1. Public Land Survey	T <u>13N</u> R <u>6E</u>	<u>E-11</u>
	T _____ R _____	_____
2. Property Controlling	S _____ T _____ R _____	_____
3. Miscellaneous	S _____ T _____ R _____	_____
Property in Sec.	S _____ T _____ R _____	_____


1999 DEC 29 P 12: 52
 REGISTER OF DEEDS
 BAY COUNTY, MICHIGAN
 Register of Deeds Stamp & File Number

RECORDED

4. Lot No. _____, Recorded Plat _____
5. Private Claims _____

I, BRIAN D FERGUSON, in a field survey on MAY, 19 99 do hereby state that under requirements of P.A. 74, Michigan P.A. of 1970, the corner points mentioned in lines 1 and 2 above were in conformance with regulations and rules therefore as required in the current manual of survey instructions of the United States Department of the Interior, Bureau of Land Management or by a decree of a Court of Law and/or that the corner points mentioned in lines 3, 4 and 5 above were in conformance with the rules of the Michigan Board of Land Surveyors or by a Decree of a Court of Law; established, re-established, monumented, recovered, found as expressed below:

NOTE: Not more than 2 corners, all in the same town and range, may be recorded on this certificate.

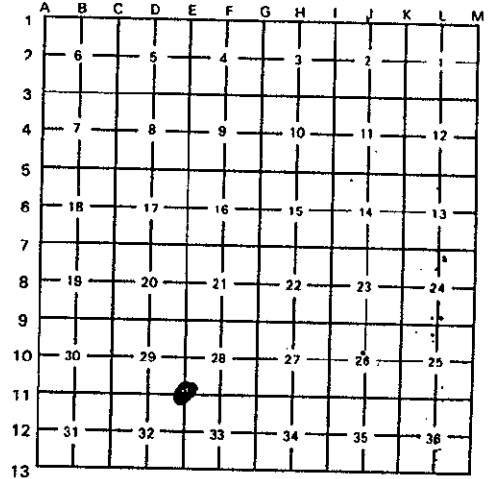

A. Description of original monument and accessories and/or subsequent restoration:

WOOD POST SET BY J. WAMPLER, DS, IN 1821. NO EVIDENCE OF ORIGINAL CORNER REMAINS.
 NO LCRC'S FOR THIS CORNER
 COS BY EDMANDS ENGINEERING, L885 P857; L888 P231
 COS BY RON PREVOST, L1107 P551; L1121 P09
 COS BY MCGINNIS, L670 P395; L746 P159

B. Description of corner evidence found and/or method applied in restoring or reestablishing corner:

FOUND 5/8" ROD IN MONUMENT BOX PER WITNESSES FROM COS'S
 MEASURED 2598.39' TO F-11 (REC 2598.54, L885 P857)
 MEASURED ANGLE IN NE QUAD OF 90°18'04" (REC 90°18'05", L746 P159)


ACCEPTED AS THE BEST AVAILABLE EVIDENCE OF THE LOCATION OF THE ORIGINAL CORNER

C. Description of monument for corner and accessories established to perpetuate locating the position of the corner:

SET 5/8" RE-BAR W / BAY COUNTY REMON. BRASS CAP & NO. 26454 IN MONUMENT BOX
 N45E 42.72' FCE LIGHT POSE (REC 42.72' L1121 P09)
 N50W 54.83' TOP CTR TELE RISER
 S10W 11.06' E. LEG ROAD SIGN
 N30W 47.56' STOP SIGN POST
 NORTH 4.5' CENTER LINE BIT PAVEMENT (REC 4.5' L1121 P09)

Signed by Brian D Ferguson Date December 15, 1999

Surveyor's Michigan License No. 26454

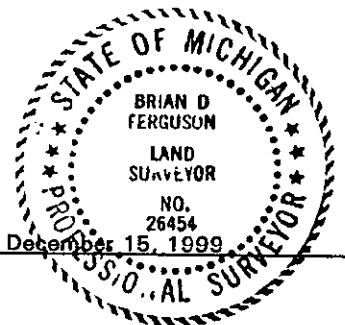

APPROVED LAND CORNER
 P.A. 345 OF 1990 - Bay County
 Date 8.05.99
MM
 Michael MacDonald P.S.

FORM APPROVED BY MICHIGAN STATE BOARD OF PROFESSIONAL SURVEYORS, JAN. 28, 1971
 REVISED MAY 14, 1975
 REVISED JAN., 1983
 REVISED OCT., 1995

004 338