

SECTION

BAY COUNTY REMONUMENTATION 1999
LAND CORNER RECORDATION CERTIFICATE
Filing Requirement of Act 74, Mich. P.A. 1970

For corners in

BAY
(County)

Located in: **MERRITT TOWNSHIP** Corner Code #

1. Public Land Survey T 13N R 6E E-13
T _____ R _____

2. Property Controlling S _____ T _____ R _____

3. Miscellaneous S _____ T _____ R _____
Property in Sec. S _____ T _____ R _____

1999 DEC 29 P 12:53

REGISTER OF DEEDS
BAY COUNTY, MICHIGAN

RECORDED

Register of Deeds Stamp & File Number

4. Lot No. _____, Recorded Plat _____
5. Private Claims _____

I, BRIAN D FERGUSON, in a field survey on MAY, 19 99 do hereby state that under requirements of P.A. 74, Michigan P.A. of 1970, the corner points mentioned in lines 1 and 2 above were in conformance with regulations and rules therefore as required in the current manual of survey instructions of the United States Department of the Interior, Bureau of Land Management or by a decree of a Court of Law and/or that the corner points mentioned in lines 3, 4 and 5 above were in conformance with the rules of the Michigan Board of Land Surveyors or by a Decree of a Court of Law; established, re-established, monumented, recovered, found as expressed below:

1	A	B	C	D	E	F	G	H	I	J	K	L	M
2		6		5		4		3		2		1	
3													
4		7		8		9		10		11		12	
5													
6		18		17		16		15		14		13	
7													
8		19		20		21		22		23		24	
9													
10		30		29		28		27		26		25	
11													
12		31		32		33		34		35		36	
13													

NOTE: Not more than 2 corners, all in the same town and range, may be recorded on this certificate.

A. Description of original monument and accessories and/or subsequent restoration:

WOOD POST SET BY J. WAMPLER, DS, IN 1821. NO EVIDENCE OF ORIGINAL CORNER REMAINS.
LCRC BY MCGINNIS, L001 P85, IN 1972
LCRC BY QUIST, L002 P516, IN 1979
COS BY MCGINNIS, L701 P263
COS BY BURGIN, L1307 P633

B. Description of corner evidence found and/or method applied in restoring or reestablishing corner:

FOUND 5/8" ROD PER LCRC'S AND COS'S
CORNER TIED TO E-1, T12N-R6E, BY LCRC, L7 P207, SAGINAW COUNTY
MEASURED 2607.83' TO D-13, REC 2608.02' L1307 P633
MEASURED 2632.98' TO E-12, REC 2633.11' L1307 P633
MEASURED 39.0' TO C-1, T12N-R6E, REC 39.0' L701 P263


ACCEPTED AS THE BEST AVAILABLE EVIDENCE OF THE LOCATION OF THE ORIGINAL CORNER

C. Description of monument for corner and accessories established to perpetuate locating the position of the corner:

SET 5/8" RE-BAR W / BAY COUNTY REMON. BRASS CAP & NO. 26454 IN MONUMENT BOX
EAST 39.00' E-1, T12N-R6E, REC 39.00' L701 P263; 39.3' L1307 P633
N50E 46.96' W LEG BTM CTR DIRECTIONAL SIGN
S40E 39.95' W COR CONC, S BRIDGE WALL
SOUTH 5.92' REBAR 4' OFF EDGE OF BIT

Signed by Brian D Ferguson
Surveyor's Michigan License No. 26454

Date December 15, 1999

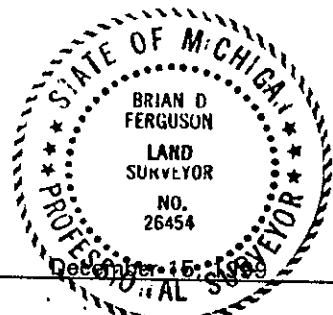

APPROVED LAND CORNER
P.A. 345 OF 1990 - Bay County
Date 11.04.99
MM
Michael MacDonald P.S.

004 336