

SECTION

BAY COUNTY REMONUMENTATION 1999
LAND CORNER RECORDATION CERTIFICATE
Filing Requirement of Act 74, Mich. P.A. 1970


For corners in

	MERRITT TOWNSHIP		
<u>BAY</u> (County)	Located in:	Corner Code #	
1. Public Land Survey	T <u>13N</u> R <u>6E</u>	<u>F-11</u>	
	T _____ R _____	_____	
2. Property Controlling	S _____ T _____ R _____	_____	
3. Miscellaneous	S _____ T _____ R _____	_____	
Property in Sec.	S _____ T _____ R _____	_____	

REGISTER OF DEEDS
 BAY COUNTY, MICHIGAN
 1999 DEC 29 P 12:53
 Register of Deeds Stamp & File Number

4. Lot No. _____, Recorded Plat _____
 5. Private Claims _____

I, BRIAN D FERGUSON, in a field survey on MAY, 19 99 do hereby state that under requirements of P.A. 74, Michigan P.A. of 1970, the corner points mentioned in lines 1 and 2 above were in conformance with regulations and rules therefore as required in the current manual of survey instructions of the United States Department of the Interior, Bureau of Land Management or by a decree of a Court of Law and/or that the corner points mentioned in lines 3, 4 and 5 above were in conformance with the rules of the Michigan Board of Land Surveyors or by a Decree of a Court of Law; established, re-established, monumented, recovered, found as expressed below:

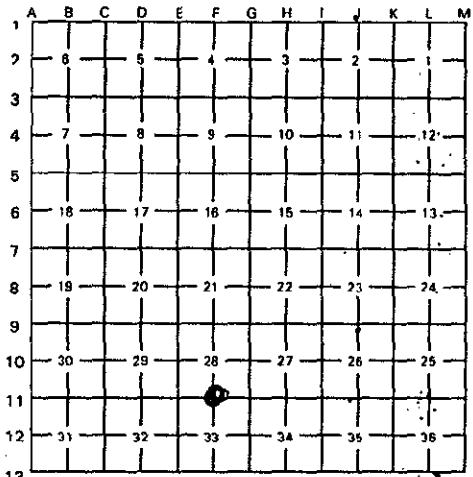

NOTE: Not more than 2 corners, all in the same town and range, may be recorded on this certificate.

A. Description of original monument and accessories and/or subsequent restoration:

WOOD POST SET BY J. WAMPLER, DS, IN 1821. NO EVIDENCE OF ORIGINAL CORNER REMAINS.
 NO LCRC'S ON THIS CORNER
 COS BY EDMANDS ENG., L888 P231; 885 P857
 COS BY MCGINNIS, L737 P294

B. Description of corner evidence found and/or method applied in restoring or reestablishing corner:


FOUND 1/2" IRON BAR (COS CALLS FOR AXLE SHAFT)
 MEASURED 2598.39' TO E-11 (REC 2598.54 IN L885 P857)
 IRON BAR IS ON LINE BETWEEN E-11 AND G-11

ACCEPTED AS THE BEST AVAILABLE EVIDENCE OF THE LOCATION OF THE ORIGINAL CORNER

C. Description of monument for corner and accessories established to perpetuate locating the position of the corner:

SET 5/8" RE-BAR W / BAY COUNTY REMON. BRASS CAP & NO. 26454 IN MONUMENT BOX
 N50E 59.31' TOP CTR TELE RISER
 N35W 36.22' STOP SIGN POST
 N35W 35.90' TOP CTR AMER RISER
 S50E 11.54' W LEG DBL ARROW SIGN

Signed by Brian D Ferguson Date December 29, 1999
 Surveyor's Michigan License No. 26454

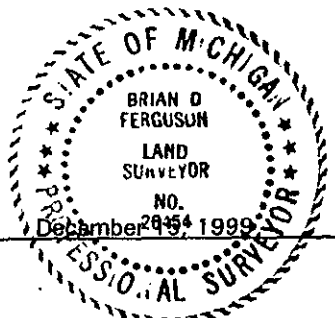

APPROVED LAND CORNER
 P.A. 345 OF 1990 - Bay County
 Date 8.05.99
MM
 Michael MacDonald P.S.
 County Representative

FORM APPROVED BY MICHIGAN STATE BOARD OF PROFESSIONAL SURVEYORS, JAN. 28, 1971
 REVISED MAY 14, 1975
 REVISED JAN., 1983
 REVISED OCT., 1995

004 335