

SECTION

BAY COUNTY REMONUMENTATION 1999
LAND CORNER RECORDATION CERTIFICATE
Filing Requirement of Act 74, Mich. P.A. 1970

For corners in

	<u>BAY</u> (County)	Located in:	MERRITT TOWNSHIP	Corner Code #
1. Public Land Survey		T <u>13N</u> R <u>6E</u>		<u>F-13</u>
		T _____ R _____		_____
2. Property Controlling	S _____ T _____ R _____			_____
3. Miscellaneous	S _____ T _____ R _____			_____
Property in Sec.	S _____ T _____ R _____			_____

RECORDED

1999 DEC 29 P 12:53

BAY COUNTY, MICHIGAN

BRIAN D. FERGUSON
REGISTER OF DEEDS

Register of Deeds Stamp & File Number

4. Lot No. _____, Recorded Plat _____
5. Private Claims _____

I, BRIAN D FERGUSON, in a field survey on MAY, 19 99 do hereby state that under requirements of P.A. 74, Michigan P.A. of 1970, the corner points mentioned in lines 1 and 2 above were in conformance with regulations and rules therefore as required in the current manual of survey instructions of the United States Department of the Interior, Bureau of Land Management or by a decree of a Court of Law and/or that the corner points mentioned in lines 3, 4 and 5 above were in conformance with the rules of the Michigan Board of Land Surveyors or by a Decree of a Court of Law; established, re-established, monumented, recovered, found as expressed below:

NOTE: Not more than 2 corners, all in the same town and range, may be recorded on this certificate.

A	B	C	D	E	F	G	H	I	J	K	L	M
1												
2	6		5		4		3		2			
3												
4	7		8		9		10		11		12	
5												
6	18		17		16		15		14		13	
7												
8	19		20		21		22		23		24	
9												
10	30		29		28		27		26		25	
11												
12	31		32		33		34		35		36	
13												

A. Description of original monument and accessories and/or subsequent restoration:

WOOD POST SET BY J. WAMPLER, DS, IN 1821. NO EVIDENCE OF ORIGINAL CORNER REMAINS.
 LCRC BY GOSS, L001 P521, IN 1973
 LCRC BY QUIST, L002 P516, IN 1979
 COS BY MCGINNIS, L701 P263
 COS BY CIOSEK, L856 P697
 COS BY MACDONALD, L980 P875

B. Description of corner evidence found and/or method applied in restoring or reestablishing corner:


FOUND 3/4" PIPE AT LOCATION PER LCRC AND COS'.
 MEASURED 25.25' EAST TO F-1, T12N-R6E, REC. 25.24'

ACCEPTED AS THE BEST AVAILABLE EVIDENCE OF THE LOCATION OF THE ORIGINAL CORNER

C. Description of monument for corner and accessories established to perpetuate locating the position of the corner:

SET 5/8" RE-BAR W / BAY COUNTY REMON. BRASS CAP & NO. 26454 IN MONUMENT BOX
 N45E 116.28' SW CORNER OF HSE #9525 (REC 116.28' LCRC)
 EAST 25.25' F-1, T12N-R6E, REC. 25.25' LCRC)
 N20W 21.70' S LEG / BTM CTR STOP SIGN
 SOUTH 68.85' BTM CTR BAY CO SIGN

Signed by Brian D Ferguson Date December 15, 1999
 Surveyor's Michigan License No. 26454

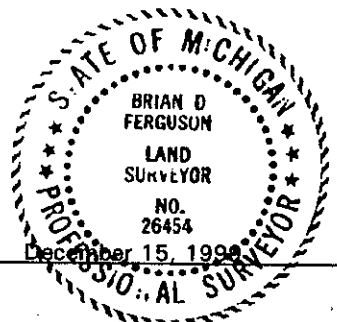

APPROVED LAND CORNER
 P.A. 345 OF 1990 - Bay County
 Date 11.18.99
MM
 Michael MacDonald P.S.
 County Representative

FORM APPROVED BY MICHIGAN STATE BOARD OF PROFESSIONAL SURVEYORS, JAN. 28, 1971
 REVISED MAY 14, 1975
 REVISED JAN., 1983
 REVISED OCT., 1996

004 334