

**BAY COUNTY REMONUMENTATION 1999  
LAND CORNER RECORDATION CERTIFICATE**  
Filing Requirement of Act 74, Mich. P.A. 1970

For corners in SECTION

BAY Located in: MERRITT TOWNSHIP  
(County) Corner Code #

- |                         |                          |             |
|-------------------------|--------------------------|-------------|
| 1. Public Land Survey   | T <u>13N</u> R <u>6E</u> | <u>G-13</u> |
|                         | T _____ R _____          | _____       |
| 2. Property Controlling | S _____ T _____ R _____  | _____       |
| 3. Miscellaneous        | S _____ T _____ R _____  | _____       |
| Property in Sec.        | S _____ T _____ R _____  | _____       |
4. Lot No. \_\_\_\_\_, Recorded Plat \_\_\_\_\_
5. Private Claims \_\_\_\_\_

**RECORDED**

1999 DEC 29 P 12:51

*Brian D Ferguson*  
REGISTER OF DEEDS  
BAY COUNTY, MICHIGAN

Register of Deeds Stamp & File Number

I, BRIAN D FERGUSON, in a field survey on MAY, 19 99 do hereby state that under requirements of P.A. 74, Michigan P.A. of 1970, the corner points mentioned in lines 1 and 2 above were in conformance with regulations and rules therefore as required in the current manual of survey instructions of the United States Department of the Interior, Bureau of Land Management or by a decree of a Court of Law and/or that the corner points mentioned in lines 3, 4 and 5 above were in conformance with the rules of the Michigan Board of Land Surveyors or by a Decree of a Court of Law; established, re-established, monumented, recovered, found as expressed below:

NOTE: Not more than 2 corners, all in the same town and range, may be recorded on this certificate.

1	A	B	C	D	E	F	G	H	I	J	K	L	M
2		6		5		4		3		2		1	
3													
4		7		8		9		10		11		12	
5													
6		18		17		16		15		14		13	
7													
8		19		20		21		22		23		24	
9													
10		30		29		28		27		26		25	
11													
12		31		32		33		34		35		36	
13													

A. Description of original monument and accessories and/or subsequent restoration:

WOOD POST SET BY J. WAMPLER, DS, IN 1821. NO EVIDENCE OF ORIGINAL CORNER REMAINS.  
LCRC BY GOSS, L001 P519, IN 1973  
COS BY MCGINNINS, L701 P281  
COS BY MACDONALD, L980 P875

B. Description of corner evidence found and/or method applied in restoring or reestablishing corner:


FOUND RR SPIKE PER LCRC AND COS BY MACDONALD

ACCEPTED AS THE BEST AVAILABLE EVIDENCE OF THE LOCATION OF THE ORIGINAL CORNER

C. Description of monument for corner and accessories established to perpetuate locating the position of the corner:

SET 5/8" RE-BAR W / BAY COUNTY REMON. BRASS CAP & NO. 26454 IN MONUMENT BOX  
N75W 170.65' TOP CTR AMER RISER  
EAST 44.20' BRASS CAP G-1, T12N-R6E  
N65E 141.85' W FCE WOOD POST  
SOUTH 8.40' SET REBAR 6' OFF BIT PAVEMENT  
N75E 141.85' FCE PWR POLE (REC 141.9')  
N80W 171.55' FCE PWR POLE (REC 171.55')

Signed by Brian D Ferguson Date December 29, 1999  
Surveyor's Michigan License No. 26454

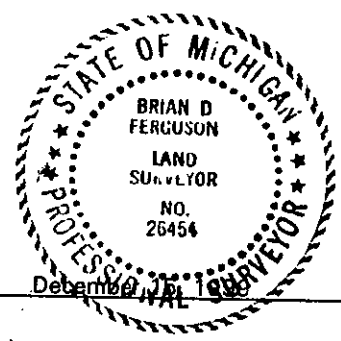

APPROVED LAND CORNER  
P.A. 345 OF 1990 - Bay County  
Date 11.07.99  
MM  
Michael MacDonald P.S.  
County Deputee

004 331