

SECTION

BAY COUNTY REMONUMENTATION 1999
LAND CORNER RECORDATION CERTIFICATE
Filing Requirement of Act 74, Mich. P.A. 1970

For corners in

<u>BAY</u> (County)	Located in:	MERRITT TOWNSHIP	Corner Code #
1. Public Land Survey	T <u>13N</u> R <u>6E</u>		<u>H-13</u>
2. Property Controlling	S _____ T _____ R _____		_____
3. Miscellaneous	S _____ T _____ R _____		_____
Property in Sec.	S _____ T _____ R _____		_____

1999 DEC 29 P 12:51
 REGISTER OF DEEDS
 BAY COUNTY, MICHIGAN
 Register of Deeds Stamp & File Number

RECORDED

4. Lot No. _____, Recorded Plat _____
5. Private Claims _____

I, BRIAN D FERGUSON, in a field survey on MAY, 19 99 do hereby state that under requirements of P.A. 74, Michigan P.A. of 1970, the corner points mentioned in lines 1 and 2 above were in conformance with regulations and rules therefore as required in the current manual of survey instructions of the United States Department of the Interior, Bureau of Land Management or by a decree of a Court of Law and/or that the corner points mentioned in lines 3, 4 and 5 above were in conformance with the rules of the Michigan Board of Land Surveyors or by a Decree of a Court of Law; established, re-established, monumented, recovered, found as expressed below:

1	A	B	C	D	E	F	G	H	I	J	K	L	M
2		6		5		4		3		2		1	
3													
4		7		8		9		10		11		12	
5													
6		18		17		16		15		14		13	
7													
8		19		20		21		22		23		24	
9													
10		30		29		28		27		26		25	
11													
12		31		32		33		34		35		30	
13													

NOTE: Not more than 2 corners, all in the same town and range, may be recorded on this certificate.

A. Description of original monument and accessories and/or subsequent restoration:

WOOD POST SET BY J. WAMPLER, DS, IN 1821. NO EVIDENCE OF ORIGINAL CORNER REMAINS.
 LCRC BY GOSS, L001 P519, IN 1973 (NO WITNESSES REMAIN)
 COS BY MCGINNIS, L701 P281
 COS BY FOLKEN, L929 P827

B. Description of corner evidence found and/or method applied in restoring or reestablishing corner:


FOUND BOAT SPIKE PER COS'S
 MEASURED 2634.80' TO I-13 (REC 2635.05')
 MEASURED 2635.54' TO G-13 (REC 2636.58')

ACCEPTED AS THE BEST AVAILABLE EVIDENCE OF THE LOCATION OF THE ORIGINAL CORNER

C. Description of monument for corner and accessories established to perpetuate locating the position of the corner:

SET 5/8" RE-BAR W / BAY COUNTY REMON. BRASS CAP & NO. 26454 IN MONUMENT BOX
 N15E 29.54' NAIL S FCE UTIL POLE (REC 31.6")
 N25E 30.8' TOP CTR AMER RISER
 EAST 45.87' H-1, T12N-R6E (REC 45.87")
 S50E 54.00' FCE STEEL FENCE POST

Signed by Brian D Ferguson Date December 15, 1999
 Surveyor's Michigan License No. 26454

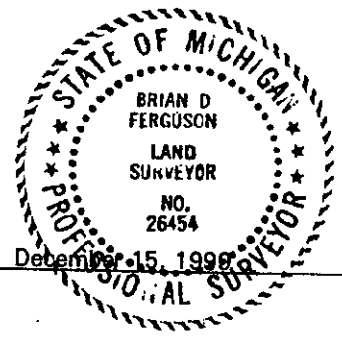

APPROVED LAND CORNER
 P.A. 345 OF 1990 - Bay County
 Date 11-18-99
MM
 Michael MacDonald P.S.
 County Representative

004 329